


PUBLIC LAND CORNERS

WEYERHAEUSER TIMBER COMPANY
 SPRINGFIELD BRANCH

TOWNSHIP 24S RANGE 2W

SECTION 19 CORNER E 1/4

COUNTY Douglas OREGON

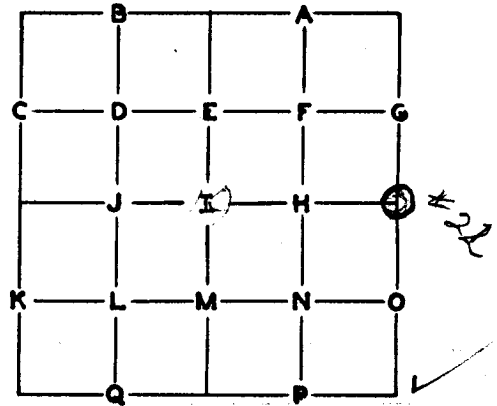

GLO SURVEY RECORD

DATE: 1883

CORNER 3" x 3" Dogwood post

PRESENT CONDITION - (DESCRIBE FULLY -
 USE PAGE 2 IF NEEDED FOR EXPLANATION.)

ACCESSORIES:

	BEARING-	LINKS-	FEET-	
<u>10' Hemlock</u>	<u>N 10° E</u>	<u>13</u>	<u>8.6</u>	<u>Gone</u>
<u>6" Vina Maple</u>	<u>S 30° W</u>	<u>9</u>	<u>5.9</u>	<u>Gone</u>

W. T. Co. SURVEY RECORD

DATE: March 1955

PRESENT CONDITION: 2" x 2" Fir pitch post
set in 1955 from original B.T.S., now
Gone

<u>46" Fir</u>	<u>N 22° E</u>	<u>22.1</u>	<u>"w" nail & plate</u>	<u>New stump, "w" nail o.k., plate gone - Replaced</u>
<u>60" Fir</u>	<u>S 79° W</u>	<u>28.0</u>	<u>"w" nail & plate</u>	<u>New stump, "w" nail & plate o.k.</u>
<u>50" Fir</u>	<u>N 23° W</u>	<u>32.9</u>	<u>"w" nail & plate</u>	<u>New stump, "w" nail & plate o.k.</u>
<u>52" Fir</u>	<u>S 12° E</u>	<u>17.3</u>	<u>"w" nail & plate</u>	<u>New stump, "w" o.k., plate gone - Replaced</u>


CORNER SET: 5/8" x 32" Monel pipe MAGNETIC DECLINATION: 20° E

1 1/2" x 10' yellow pipe for marker driven along side monel pipe

BEARING AND DISTANCE TO ABOVE IDENTIFIED SURVEY ACCESSORIES:

BEARING-	FEET-	SURVEY-
<u>N 22° E</u>	<u>22.1</u>	<u>W. T. Co.</u>
<u>S 79° W</u>	<u>28.0</u>	<u>W. T. Co.</u>
<u>N 23° W</u>	<u>32.9</u>	<u>W. T. Co.</u>
<u>S 12° E</u>	<u>17.3</u>	<u>W. T. Co.</u>

SECTION 19 TOWNSHIP 245 RANGE 24

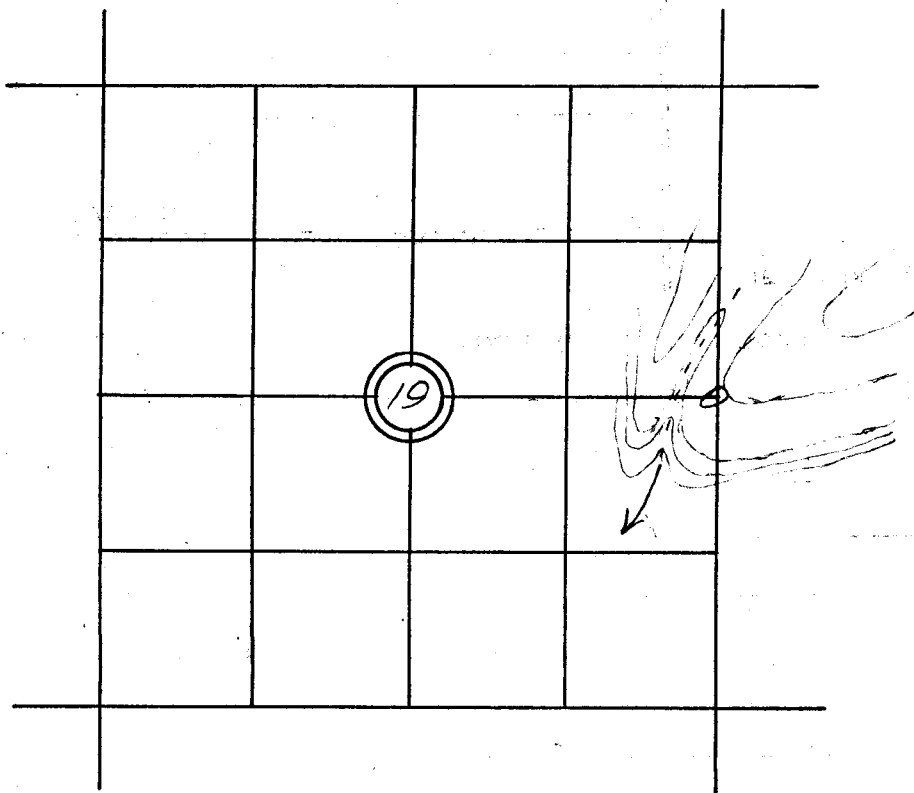

— // — // — // — LINE MARKED BY NOTCH CUT IN BLAZE.

○ — KNOWN CORNER.

⊗ — REFERENCED CORNER BY WEYERHAEUSER METHOD.

ACCESSORIES ADDED THIS DATE:

MAGNETIC DECLINATION _____

	BEARING	FEET	ORIG. B.T.	"W" NAIL	PLATE	BRASS DISC

IDENTIFIED ON PHOTO:

INFORMATION ON LOCATION OF CORNER AS NOW SET:

GROUND COVER: Recently logged, slash not burned.

(USING FORM LINES SKETCH TOPOG AT CORNER ON PAGE 2 PLAT)

SLOPE FACES (GIVE BEARING IN DEGREES) 545°W ON MINUS (-) 5%

NORTH: Level for 200'

SOUTH: -1% for 200'

EAST: +10% for 200'

WEST: -16% for 120'

FROM CORNER -

WORK DONE FOR W. T. CO.:

FIELD NOTES IN BOOK: 558

BY: M.D. Hale
ENGINEER - SURVEYOR

DATE: 7-18-58

UNDER THE SUPERVISION OF:

Det. H. Ward

ASSISTED BY: Ray Warner, Warren Dixon,
Elder Casa

COPIES SENT TO: _____

SEAL