


PUBLIC LAND CORNERS

WEYERHAEUSER COMPANY
 SPRINGFIELD BRANCH

TOWNSHIP 24S RANGE 2W
 SECTION 28 CORNER SW
 COUNTY Douglas OREGON

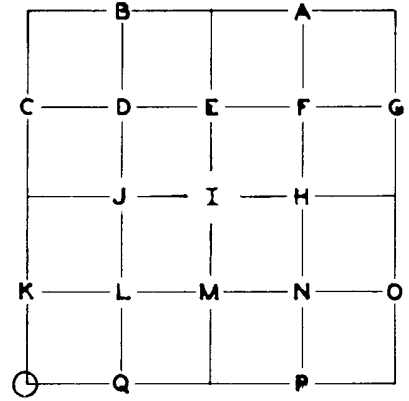


GLO SURVEY RECORD				PRESENT CONDITION - (DESCRIBE FULLY - USE PAGE 2 IF NEEDED FOR EXPLANATION.)	
DATE: <u>1951</u>					
CORNER <u>Brass Cap</u>					
ACCESSORIES:					
	BEARING-	LINKS-	FEET-		
"No remaining evidence of the Original Corner"					
11" Fir	N46°E	42	27.7	14" Fir - face healed over	
14" Fir	S19°E	33	21.8	16" Fir - scribing visible	
16" Fir	S75°W	15	10.0	20" Fir - face healed	
12" Fir	N07°W	30	19.8	12" Fir - face healed	
Weyerhaeuser SURVEY RECORD				PRESENT CONDITION:	
DATE: <u>1948-49</u>					
Pipe set by staff compass survey by Weyerhaeuser & Rock Island				This corner was made obsolete by 1951 Cadastral resurvey.	
Ref:	14" Fir	N40°E	18.0'	Plate Removed	
	18" Fir	S35°E	8.8'	Plate Removed	
	16" Fir	S20°W	13.2	Plate Removed	
	8" Fir	N36°W	16.6	Plate Removed	
				See Page 2	

CORNER SET: Brass Cap as set by 1951 Cadastral Resurvey MAG. DECL.: 20°

BEARING AND DISTANCE TO ABOVE IDENTIFIED SURVEY ACCESSORIES:

BEARING-	FEET-	SURVEY-	
N46°E	27.7	1951	Distance to center of BT
S18°E	21.8	1951	Distance to center of BT
S77°W	10.0	1951	Distance to center of BT
N05°W	19.8	1951	Distance to center of BT

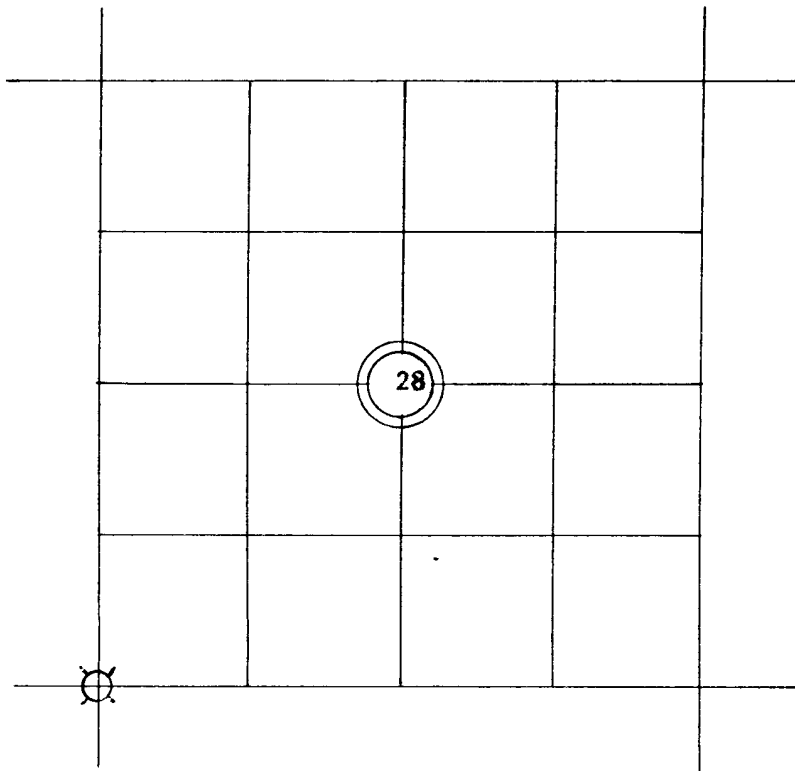

— // — // — // — LINE MARKED BY NOTCH CUT IN BLAZE.

○ ——— KNOWN CORNER.

⊗ ——— REFERENCED CORNER
BY WEYERHAEUSER
METHOD.

4/8/70

I found no record that this staff compass corner or its' accessories had been removed after it was made obsolete by the 1951 Cadastral retracement, nor any record of Weyerhaeuser references for the 1951 Cadastral Corner; however, the accessories shown below were previously done and found by me in the field.

ACCESSORIES ~~ADDED TO THIS DATE~~

MAGNETIC DECLINATION 20°

Found in Field	BEARING	FEET	ORIG. B.T.	"W" NAIL	PLATE	BRASS DISC
4/8/70						
14" Fir	N47°E	27.3	1951 X	X	X	
16" Fir	S18°E	21.5	1951 X	X	X	
20" Fir	S74°W	9.4	1951 X	X	X	
12" Fir	N05°W	18.9	1951 X	X	X	

IDENTIFIED ON PHOTO:

INFORMATION ON LOCATION OF CORNER AS NOW SET:

GROUND COVER:

(USING FORM LINES SKETCH TOPOG AT CORNER ON PAGE 2 PLAT)

SLOPE FACES (GIVE BEARING IN DEGREES) East ON MINUS (-) %

NORTH: +15%

SOUTH: Level

EAST: -60%

WEST: +60%

FROM CORNER ↓

WORK DONE FOR W. CO.

FIELD NOTES IN BOOK:

BY: Glen McCheesney DATE: 4/8/70
ENGINEER - SURVEYOR

UNDER THE SUPERVISION OF:

ASSISTED BY:

COPIES SENT TO: