


# PUBLIC LAND CORNERS

WEYERHAEUSER COMPANY  
 SPRINGFIELD BRANCH

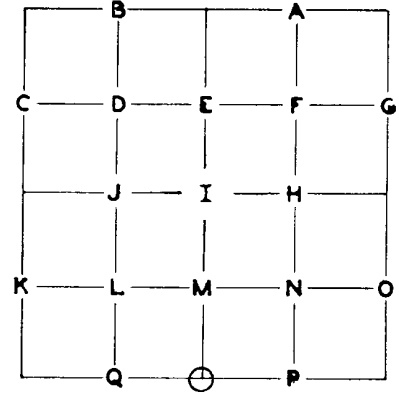

TOWNSHIP 24S RANGE 2W  
 SECTION 30 CORNER S $\frac{1}{2}$   
 COUNTY Douglas OREGON

<p><b>GLO SURVEY RECORD</b></p> <p>DATE: <u>1951</u></p> <p>CORNER <u>Brass Cap</u></p>	<p><b>PRESENT CONDITION - (DESCRIBE FULLY - USE PAGE 2 IF NEEDED FOR EXPLANATION.)</b></p> <p><u>Found</u></p>																																				
<p><b>ACCESSORIES:</b></p> <table border="1" style="width:100%; border-collapse: collapse;"> <thead> <tr> <th style="width:15%;">BEARING-</th> <th style="width:15%;">LINKS-</th> <th style="width:15%;">FEET-</th> <th style="width:55%;"></th> </tr> </thead> <tbody> <tr> <td><u>36" Fir</u></td> <td><u>N34<math>\frac{1}{2}</math><sup>o</sup>E</u></td> <td><u>103</u></td> <td><u>68.0</u></td> </tr> <tr> <td><u>40" Fir</u></td> <td><u>N26<sup>o</sup>W</u></td> <td><u>131</u></td> <td><u>86.5</u></td> </tr> <tr> <td> </td> <td> </td> <td> </td> <td> </td> </tr> <tr> <td> </td> <td> </td> <td> </td> <td> </td> </tr> <tr> <td> </td> <td> </td> <td> </td> <td> </td> </tr> <tr> <td> </td> <td> </td> <td> </td> <td> </td> </tr> <tr> <td> </td> <td> </td> <td> </td> <td> </td> </tr> <tr> <td> </td> <td> </td> <td> </td> <td> </td> </tr> </tbody> </table>		BEARING-	LINKS-	FEET-		<u>36" Fir</u>	<u>N34<math>\frac{1}{2}</math><sup>o</sup>E</u>	<u>103</u>	<u>68.0</u>	<u>40" Fir</u>	<u>N26<sup>o</sup>W</u>	<u>131</u>	<u>86.5</u>																								
BEARING-	LINKS-	FEET-																																			
<u>36" Fir</u>	<u>N34<math>\frac{1}{2}</math><sup>o</sup>E</u>	<u>103</u>	<u>68.0</u>																																		
<u>40" Fir</u>	<u>N26<sup>o</sup>W</u>	<u>131</u>	<u>86.5</u>																																		
<p><b>SURVEY RECORD</b></p> <p>DATE: _____</p>	<p><b>PRESENT CONDITION:</b> _____</p>																																				

CORNER SET: Brass cap in place as found MAG. DECL.: 20<sup>o</sup>

**BEARING AND DISTANCE TO ABOVE IDENTIFIED SURVEY ACCESSORIES:**

BEARING-	FEET-	SURVEY-	
<u>N35<sup>o</sup>E</u>	<u>69.0</u>	<u>1951</u>	<u>Distance to center of BT</u>
<u>N26<sup>o</sup>W</u>	<u>86.5</u>	<u>1951</u>	<u>Distance and bearing to root hole of down BT.</u>



ACCESSORIES ADDED THIS DATE:

MAGNETIC DECLINATION 20°

	BEARING	FEET	ORIG. B.T.	"W" NAIL	PLATE	BRASS DISC
40" Fir	N35°E	67.8	GLO 1951	X	X	
26" Cedar Snag	N45°W	66.4		X	X	

IDENTIFIED ON PHOTO:

INFORMATION ON LOCATION OF CORNER AS NOW SET:

GROUND COVER: 15 yr. old fir reproduction

(USING FORM LINES SKETCH TOPOG AT CORNER ON PAGE 2 PLAT)

SLOPE FACES (GIVE BEARING IN DEGREES) N35°E ON MINUS (-) 52 %

Corner is at north edge of old logging

NORTH: - 50% old growth to east and west

FROM CORNER SOUTH: + 52% old logging to east and west

EAST: - 20% old growth to north, old logging & reproduction to south.

WEST: + 10% along north side of old logging - scattered old growth to north

WORK DONE FOR W. CO.

FIELD NOTES IN BOOK:

BY: Glen McChesney DATE: 11/19/69

~~ENGINEER SURVEYOR~~  
Project Engineer

ASSISTED BY:

UNDER THE SUPERVISION OF:

COPIES SENT TO:

SEAL

PAGE 3

53/118