


PUBLIC LAND CORNERS

WEYERHAEUSER COMPANY
 SPRINGFIELD BRANCH

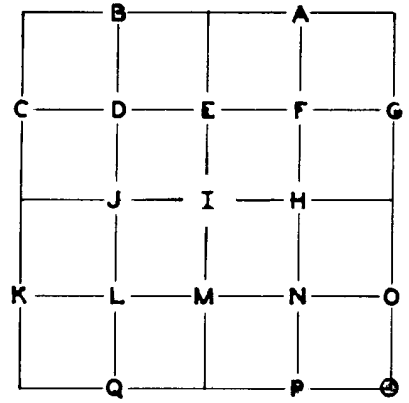

TOWNSHIP 24 S RANGE 2 W
 SECTION 7 CORNER S E
 COUNTY Douglas OREGON

GLO SURVEY RECORD				PRESENT CONDITION - (DESCRIBE FULLY - USE PAGE 2 IF NEEDED FOR EXPLANATION.)
DATE: <u>Sept. 23, 1894</u> CORNER <u>Post 4'x4" sq. 24 ins in ground</u>				
ACCESSORIES:				
BEARING-	LINKS-	FEET-		
8" Hem	N 76 E	37	24.4	Down and rotted no scribing Root wad and rotted tree remain
6" Hem	S 70 E	21	13.9	Visible scribing
6" Cedar	S 41-30 W	17	11.2	Standing, face, no visible scribing
24" Cedar	N 39 W	41	27.1	Old face- no visible scribing
Weyerhaeuser Co SURVEY RECORD				PRESENT CONDITION: _____
DATE: _____ No record as of now.				

CORNER SET: _____ MAG. DECL.: 20 degrees E.

BEARING AND DISTANCE TO ABOVE IDENTIFIED SURVEY ACCESSORIES:

BEARING-	FEET-	SURVEY -	
N 65 E	24.4		Root wad hole of 8" Hem.
S 70 E	13.4		To scribing on 6" Hem.
S 42 W	10.4		To scrbing on 12" Cedar (with douglas appraisal tag)
N 39 W	25.6		To face on 30" Cedar.

ACCESSORIES ADDED THIS DATE:

MAGNETIC DECLINATION 20 degrees

	BEARING	FEET	ORIG. B.T.	"W" NAIL	PLATE	BRASS DISC
30" Cedar	N 42 W	24.1	/	/	/	
60" Fir	S 81 W	20.3		/	/	
30" Cedar	S 10 E	42.0		/	/	
40" Cedar	N 85½ E	68.3		/	/	

IDENTIFIED ON PHOTO:

INFORMATION ON LOCATION OF CORNER AS NOW SET:

GROUND COVER: Old growth fir and hem with hem and cedar under growth

(USING FORM LINES SKETCH TOPOG AT CORNER ON PAGE 2 PLAT)

SLOPE FACES (GIVE BEARING IN DEGREES) Due North ON MINUS (-) 70 %

Old

NORTH: - 70% for 130' to C.G. 315

SOUTH: + 76%

EAST: About level

WEST: - 18%

FROM CORNER ↓

WORK DONE FOR W. CO. _____

FIELD NOTES IN BOOK: _____

BY: Charles Volz DATE: 11/25/68

~~ENGINEER - SURVEYOR~~

ASSISTED BY: Len Wilson

Leon Warren

COPIES SENT TO: _____

UNDER THE SUPERVISION OF:

SEAL

PAGE 3

53/110