


PUBLIC LAND CORNERS

WEYERHAEUSER COMPANY
 SPRINGFIELD BRANCH

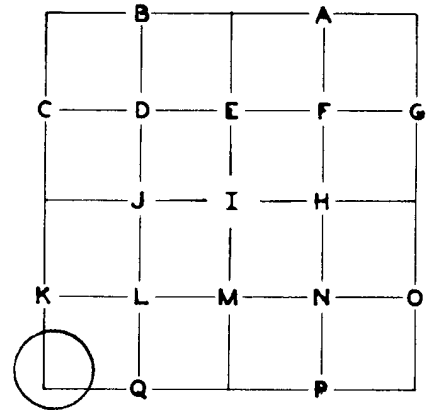

TOWNSHIP 24S RANGE 2W
 SECTION 7 CORNER SW
 COUNTY Douglas OREGON

GLO SURVEY RECORD				PRESENT CONDITION - (DESCRIBE FULLY - USE PAGE 2 IF NEEDED FOR EXPLANATION.)
CORNER <u>DATE: 1871</u> <u>Cedar Post</u>				No trace
ACCESSORIES:				
12" Maple	BEARING- N15°E	LINKS- 40	FEET- 26.4	14" Maple Stump - rotted face.
36" Fir	S50°E	16	10.6	Gone - destroyed by logging.
12" Maple	S40°W	10	6.6	Gone - destroyed by logging.
16" Fir	N45°W	37	24.4	Gone - destroyed by logging.
Weyerhaeuser SURVEY RECORD DATE: <u>7/20/54</u> R. Elm & P. Preppernau - Found NE and NW original BTs, set pipe & referenced with plates and "W" nails:				PRESENT CONDITION:
14" Maple BT	N15°E	27.2'		14" Maple Stump - plate gone - "W" nail OK
52" Fir	S77°E	47.5'		52" down Fir Stump - plate gone - "W" nail OK
34" Fir	S59°W	33.8'		Gone - destroyed by logging.
38" Fir BT	N40°W	24.4'		Gone - destroyed by logging.

CORNER SET: 1 1/2" x 36" iron pipe set from MAG. DECL.: 20°
 NE BT by distance and bearing as determined by W. Co. 1954 call.

BEARING AND DISTANCE TO ABOVE IDENTIFIED SURVEY ACCESSORIES:

BEARING-	FEET-	SURVEY-	
N15E	27.2	1871	BT and 1954 W. Co. witness tree to center of root hold.
S77E	47.5	1954	

ACCESSORIES ADDED THIS DATE: 6/10/70

MAGNETIC DECLINATION

20°

	BEARING	FEET	ORIG. B.T.	"W" NAIL	PLATE	BRASS DISC
44" Fir Stump	N56°W	37.2	-	X	X	-
36" Fir Stump	S74°W	28.4	-	X	X	-
30" Fir Stump	S49°E	88.0	-	X	X	-

IDENTIFIED ON PHOTO:

INFORMATION ON LOCATION OF CORNER AS NOW SET:

GROUND COVER: Logging Slash

(USING FORM LINES SKETCH TOPOG AT CORNER ON PAGE 2 PLAT)

SLOPE FACES (GIVE BEARING IN DEGREES) South ON MINUS (-) 51 %

NORTH: +40% 100' to Sta. 38+50 on C G 340 road.

FROM CORNER ↓

SOUTH: -51%

EAST: +30%

WEST: -15%

WORK DONE FOR W. CO.

FIELD NOTES IN BOOK:

BY: D. L. Ellis DATE: 6/10/70

~~XXXXXXXXXXXXXXXXXXXX~~

ASSISTED BY: L. Wilson

UNDER THE SUPERVISION OF:

COPIES SENT TO:

SEAL

PAGE 3

53/110