


PUBLIC LAND CORNERS

WEYERHAEUSER COMPANY
 SPRINGFIELD BRANCH

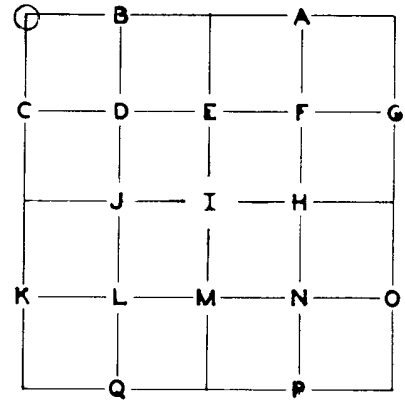

TOWNSHIP 24S RANGE 2W
 SECTION 10 CORNER NW
 COUNTY Douglas OREGON

GLO SURVEY RECORD				PRESENT CONDITION - (DESCRIBE FULLY - USE PAGE 2 IF NEEDED FOR EXPLANATION.)	
DATE: <u>1894</u>					
CORNER <u>Post</u>				No trace of original	
ACCESSORIES:					
	BEARING-	LINKS-	FEET-		
18" Fir	N27½°E	50	33.0	22" Fir-scribing visible	
30" Fir	S46½°E	18	11.9	42" Fir-face healed over	
30" Hemlock	S33°W	28	18.5	40" Hemlock - scribing visible	
30" Fir	N23°W	47	31.0	32" Fir-scribing visible	
Weyerhaeuser Co. SURVEY RECORD				PRESENT CONDITION:	
DATE: <u>7/19/54</u>					
Elm & Preppernau found 4 BTs, set pipe and referenced with 4 tags:				Found post but no pipe was ever set.	
22" Fir	BT N28°E	33.1'		Removed plates - superseded by new references	
42" Fir	BT S51°E	10.8'		See Accessories Added This Date, Page 3	
40" Hem.	BT S74°W	19.0'			
32" Fir	BT N23°W	27.4'			

CORNER SET: Brass cap set by Douglas County MAG. DECL.: 20°
 Survey Crew

BEARING AND DISTANCE TO ABOVE IDENTIFIED SURVEY ACCESSORIES:

BEARING-	FEET-	SURVEY -
N28°E	33.0	1894
S48°E	11.9	1894
S27°W	20.0	1894
N21°W	27.0	1894

ACCESSORIES ADDED THIS DATE:

MAGNETIC DECLINATION 20°

	BEARING	FEET	ORIG. B.T.	"W" NAIL	PLATE	BRASS DISC
22" Fir	N29°E	32.8	X	X	X	-
42" Fir	S51°E	10.4	X	X	X	-
40" Hemlock	S25°W	19.0	X	X	X	-
30" Fir	N23°W	27.4	X	X	X	-

IDENTIFIED ON PHOTO:

INFORMATION ON LOCATION OF CORNER AS NOW SET:

GROUND COVER: Hemlock reproduction & rhododendron

(USING FORM LINES SKETCH TOPOG AT CORNER ON PAGE 2 PLAT)

SLOPE FACES (GIVE BEARING IN DEGREES) N40°W ON MINUS (-) 70 %

NORTH: - 52% virgin old growth

SOUTH: + 40% " "

EAST: + 42% " "

WEST: - 55% " " Approx. 30' to draw C-N

WORK DONE FOR W. CO.

FIELD NOTES IN BOOK:

BY: Glen [unclear] DATE: 10/25/68

ENGINEER SUPERVISOR
Project Engineer

ASSISTED BY: Douglas County Survey crew present.

UNDER THE SUPERVISION OF:

COPIES SENT TO:

53/110