

PUBLIC LAND CORNERS


PAGE 3

WEYERHAEUSER TIMBER COMPANY
 SPRINGFIELD BRANCH

TOWNSHIP 24S RANGE 2W

SECTION 10 CORNER SE

COUNTY Douglas OREGON

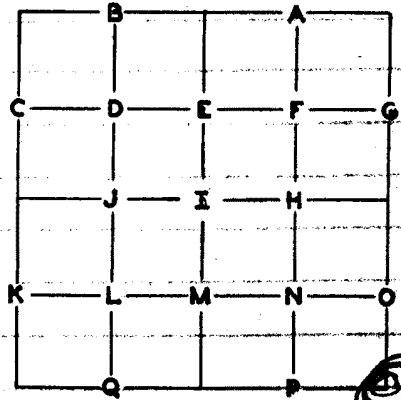

GLO SURVEY RECORD

DATE: 1894

CORNER Post

PRESENT CONDITION - (DESCRIBE FULLY - USE PAGE 2 IF NEEDED FOR EXPLANATION)

No trace original

ACCESSORIES:

	BEARING-	LINKS-	FEET-
<u>8" Yew</u>	<u>N51E</u>	<u>48</u>	<u>31.7</u>
<u>30" Fir</u>	<u>S20E</u>	<u>33</u>	<u>21.8</u>
<u>14" Hem.</u>	<u>S7W</u>	<u>68</u>	<u>44.9</u>
<u>5" Maple</u>	<u>N22W</u>	<u>23</u>	<u>15.2</u>

12" Yew - Scribing visible on upper face, lower face rotten.
34" Fir Snag Scribing visible.
16" Hem. Scribing visible.
6" Vine maple broken over at base with axe marks but Scribing not visible.

SURVEY RECORD

DATE: _____

PRESENT CONDITION: _____

CORNER SET: 3" Square 1/2" Maple post MAG. DECL: 20°

BEARING AND DISTANCE TO ABOVE IDENTIFIED SURVEY ACCESSORIES:

BEARING-	FEET-	SURVEY -	
<u>N51E</u>	<u>31.7</u>	<u>GLO</u>	<u>12" Yew</u>
<u>S21E</u>	<u>21.8</u>	<u>GLO</u>	<u>34" Fir Snag</u>
<u>S5W</u>	<u>45.6</u>	<u>GLO</u>	<u>16" Hem</u>
<u>N22W</u>	<u>15.8</u>	<u>GLO</u>	<u>Broken vine maple</u>

CS 53/110-22

10

ACCESSORIES ADDED THIS DATE:

MAGNETIC DECLINATION 20°

	BEARING	FEET	ORIG. B.T.	"W" NAIL	PLATE	BRASS DISC
50" Fir Stump	N79E	4.7	—	X	X	—
34" Fir Snag	S23E	21.5	X	X	X	—
16" Hem.	S5W	44.8	X	X	X	—
40" Fir	S86W	41.8	—	X	X	

IDENTIFIED ON PHOTO:

INFORMATION ON LOCATION OF CORNER AS NOW SET:

GROUND COVER: Rhodo-V. Maple

(USING FORM LINES SKETCH TOPOG AT CORNER ON PAGE 2 PLAT)

SLOPE FACES (GIVE BEARING IN DEGREES) South ON MINUS (-): 30 %

NORTH: +36% Old growth to E. and W

SOUTH: -30% 30' draw C-S40 W. Logged to E, old growth W.

EAST: -5% 15', +43% Old growth to N, logged to S.

WEST: +18% Through old growth.

WORK DONE FOR W. T. CO.:

FIELD NOTES IN BOOK: _____

BY: Glen McChesney DATE: Aug 12, 1958
ENGINEER - SURVEYOR

UNDER THE SUPERVISION OF:

ASSISTED BY: _____

COPIES SENT TO: _____

SEAL