


PUBLIC LAND CORNERS

WEYERHAEUSER COMPANY
 SPRINGFIELD BRANCH

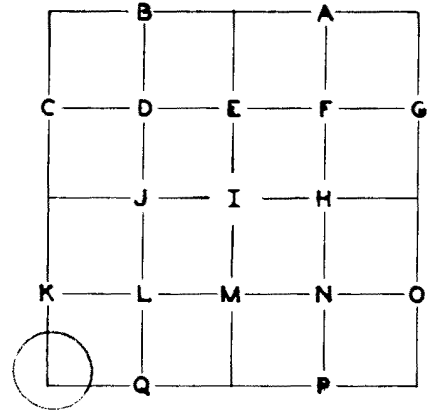

TOWNSHIP 24S RANGE 2W
 SECTION 16 CORNER SW
 COUNTY Douglas OREGON

GLO SURVEY RECORD				PRESENT CONDITION - (DESCRIBE FULLY - USE PAGE 2 IF NEEDED FOR EXPLANATION.)	
DATE: <u>9/20/1894</u>					
CORNER <u>15" x 8" x 6" Stone</u>				Found stone in place	
ACCESSORIES:					
36" Fir	BEARING- N25°E	LINKS- 30	FEET- 19.8	60" Fir - face grown over - Bearing is N45°E instead of GLO call of N25°E	
40" Fir	S40°E	12	7.9	48" Fir Snag - scribing visible	
15" Fir	S36°W	70	46.2	18" Fir - face healed over	
24" Fir	N75°W	31	20.5	36" Fir - face healed over	
SURVEY RECORD				PRESENT CONDITION:	
DATE:					

CORNER SET: Original stone in place MAG. DECL.: 20°
 as found.

BEARING AND DISTANCE TO ABOVE IDENTIFIED SURVEY ACCESSORIES:

BEARING-	FEET-	SURVEY -	
N45°E	19.6	1894	Center of tree measurement - Note bearing is N45°E instead of GLO call of N25°E
S40°E	7.9	"	Center of tree measurement
S36°W	44.7	"	Center of tree measurement
N73°W	20.8	"	Center of tree measurement

ACCESSORIES ADDED THIS DATE: 7/3/70

MAGNETIC DECLINATION 2°

	BEARING	FEET	ORIG. B.T.	"W" NAIL	PLATE	BRASS DISC
48" Fir Snag	S36°E	6.4	X	X	X	-
60" Fir	N46°E	16.9	X	X	X	-
18" Fir	S35½°W	43.3	X	X	X	-
36" Fir	N73°W	18.8	X	X	X	-

IDENTIFIED ON PHOTO:

INFORMATION ON LOCATION OF CORNER AS NOW SET:

GROUND COVER: Old growth fir and hemlock

(USING FORM LINES SKETCH TOPOG AT CORNER ON PAGE 2 PLAT)

SLOPE FACES (GIVE BEARING IN DEGREES) S60°W ON MINUS (-) 40% %

NORTH: +10% for 25' to 10' rock ledge.

FROM CORNER | SOUTH: -25% for 30' then descent steepens

EAST: +18%

WEST: -32%

WORK DONE FOR W. CO.

FIELD NOTES IN BOOK:

BY: L. B. Wilson DATE: 7/3/70

~~ENGINEER SURVEYOR~~

ASSISTED BY: K. P. Perkins

UNDER THE SUPERVISION OF:

COPIES SENT TO: