

COPY

orig
in
T23-3

NOT
TYPED IN
T 24-3


PUBLIC LAND CORNERS

WEYERHAEUSER COMPANY
SPRINGFIELD BRANCH

TOWNSHIP 24S RANGE 3W

SECTION 4 CORNER NE

COUNTY Douglas OREGON

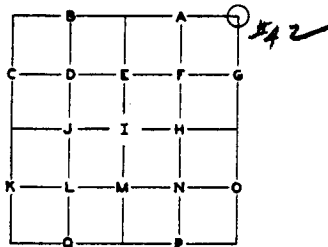

ACCESSORIES ADDED THIS DATE:

MAGNETIC DECLINATION 20° E

	BEARING	FEET	ORIG.B.T.	"W" NAIL	PLATE	BRASS DISC
46" Fir	N 12° E	17.7	X	X	X	---
62" Fir	N 58° W	33.9	---	X	X	---
36" Fir	S 39° W	67.8	---	X	X	---
36" Fir (1946 Plate)	S 17° W	7.3	X	X	X	---

IDENTIFIED ON PHOTO:

INFORMATION ON LOCATION OF CORNER AS NOW SET:

GROUND COVER: Wind throw to be logged 1965

(USING FORM LINES SKETCH TOPOG AT CORNER ON PAGE 2 PLAT)

SLOPE FACES (GIVE BEARING IN DEGREES) East ON MINUS (-) 50 %

NORTH: _____

SOUTH: _____

EAST: _____

WEST: _____

FROM CORNER 1

WORK DONE FOR W. CO.

FIELD NOTES IN BOOK:

BY: D. H. Jordan DATE: 12/16/64

ENGINEER - SURVEYOR

ASSISTED BY: Harley Case

UNDER THE SUPERVISION OF:

FILED
RECEIVED

COPIES SENT TO: _____

SEAL PAGE 3

MAR 12 1965

GLO SURVEY RECORD		PRESENT CONDITION - (DESCRIBE FULLY - USE PAGE 2 IF NEEDED FOR EXPLANATION.)	
DATE: <u>1882</u>			
CORNER <u>Post</u>		<u>No evidence</u>	
ACCESSORIES:			
	BEARING-	LINKS-	FEET-
36" Spruce	S 70° E	35	23.10
36" Spruce	S 20° W	11	7.3
36" Douglas Fir	N 60° W	5	3.30
40" Douglas Fir	N 10° E	70	46.2
			<u>No evidence - probably Douglas Fir</u>
			<u>36" D. F. now snag rootwad, corner pt. of face</u>
			<u>40" D. F. Windfall scribing on bark visible</u>
			<u>46" D. F. Snag bark sloughed away - no scribing</u>
SURVEY RECORD		PRESENT CONDITION:	
DATE: _____		_____	

CORNER SET: None MAG. DECL.: 20° E

BEARING AND DISTANCE TO ABOVE IDENTIFIED SURVEY ACCESSORIES:

BEARING-	FEET-	SURVEY-	
S 17° W	7.3	1882	Measured to bark

PAGE 1

CS 53/11-5

COUNTY SURVEYOR
DOUGLAS COUNTY, ORE.