


PUBLIC LAND CORNERS

bvce 5

WEYERHAEUSER TIMBER COMPANY
 SPRINGFIELD BRANCH

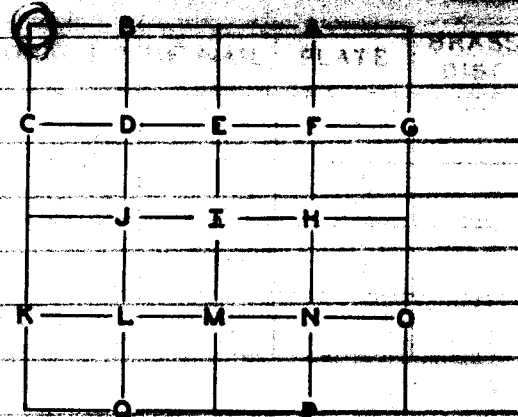

TOWNSHIP 245 RANGE 3W

SECTION 4 CORNER NW

COUNTY Douglas OREGON

GLO SURVEY RECORD

DATE: 1882
 CORNER Post

PRESENT CONDITION - (DESCRIBE FULLY -
 USE PAGE 2 IF NEEDED FOR EXPLANATION.)

Gone

ACCESSORIES:

METHOD

BY MEASUREMENT

UNRECOVERED CORNER

	BEARING-	LINKS-	FEET-	
6" Maple	N40E	20	13.2	No trace
5" Maple	S60E	36	23.8	Stub of vine maple
36" Spruce	S5W	8	5.3	64" Fir, not a spruce.
7" Maple	N25W	35	23.1	No trace.

GLO SURVEY RECORD

DATE: 1950

PRESENT CONDITION:

Brass cap				Found
8" Hem. N53 1/2 E	30 lns.	19.8'		10" Hem. Scribing Visible
8" Hem S18 1/2 E	31 lns.	20.5'		8" Hem. Scribing Visible
12" Hem S70 3/4 W	57 lns.	37.5'		14" Hem. Scribing Visible
18" Yew N49 1/2 W	97 lns.	64.0'		18" Yew - Scribing Visible.

CORNER SET: Brass cap in place

MAG. DECL: 20°

BEARING AND DISTANCE TO ABOVE IDENTIFIED SURVEY ACCESSORIES:

BEARING-	FEET-	SURVEY-	
S60E	24	GLO 182	Vine Maple Stub.
S5W	5.3	"	64" Fir
N53E	19.8	GLO 150	10" Hem.
S18E	20.5	"	8" Hem.
S71W	37.5	"	14" Hem
N49W	66.0	"	18" Yew

bvce

CS 53/111-28

ACCESSORIES ADDED THIS DATE:

MAGNETIC DECLINATION 20°

bvices

	BEARING	FEET	ORIG. B.T.	"W" NAIL	PLATE	BRASS DISC
8" Hem	N52E	17.9	1950	X	X	
64" Fir	S15W	51.0	1882	X	X	
8" Hem	S16E	20.2	1950	X	X	
18" Yew	N49W	66.0	1950	X	X	

IDENTIFIED ON PHOTO:

INFORMATION ON LOCATION OF CORNER AS NOW SET:

GROUND COVER:

(USING FORM LINES SKETCH TOPOG AT CORNER ON PAGE 2 PLAT)

SLOPE FACES (GIVE BEARING IN DEGREES) S40E ON MINUS (-) 40%

NORTH: +35° 70' old growth to North, logged to South.

SOUTH: -75° 15' to Cr. G.E. logged to top of old growth to West.

EAST: -35° 70' old growth to North, logged to South.

WEST: +20° 50' old growth.

FROM CORNER

WORK DONE FOR W. T. CO.:

FIELD NOTES IN BOOK:

BY: Glen McChesney
ENGINEER - SURVEYOR

DATE: 5/16/58

UNDER THE SUPERVISION OF:

ASSISTED BY:

COPIES SENT TO:

SEAL

PAGE 3