


# PUBLIC LAND CORNERS

WEYERHAEUSER TIMBER COMPANY  
SPRINGFIELD BRANCH

TOWNSHIP 24S RANGE 3W

SECTION 4 CORNER N 1/4

COUNTY Douglas OREGON

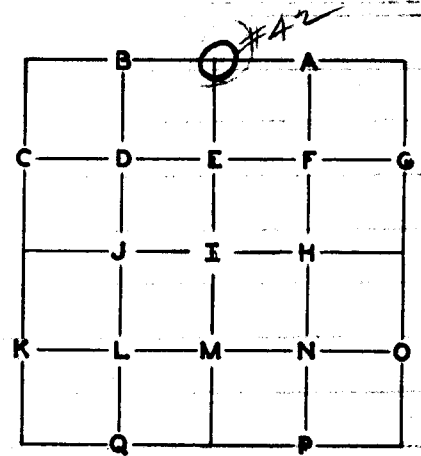

**GLO SURVEY RECORD**

DATE: 1882

CORNER 5" Hem marked 1/4 S North face

**PRESENT CONDITION - (DESCRIBE FULLY - USE PAGE 2 IF NEEDED FOR EXPLANATION.)**

1 Chopped out and found scribed on lower face on North side of 12" Hemlock.

**ACCESSORIES:**

	BEARING-	LINKS-	FEET-
<u>14" Cedar</u>	<u>S</u>	<u>10</u>	<u>60.6</u>
<u>14" Hem</u>	<u>E</u>	<u>20</u>	<u>13.2</u>

Scribing visible on 26" Cedar.

No Trace.

**SURVEY RECORD**  
DATE: \_\_\_\_\_

**PRESENT CONDITION:** \_\_\_\_\_

CORNER SET: 12" Hemlock, original.

MAG. DECL: 20°

**BEARING AND DISTANCE TO ABOVE IDENTIFIED SURVEY ACCESSORIES:**

BEARING-	FEET-	SURVEY -	
<u>S13W</u>	<u>9.4</u>	<u>GLO</u>	<u>26" Cedar</u>

CS 53/111-29


--- REFERENCED CORNER  
BY WEYERHAEUSER  
METHOD.



--- KNOWN CORNER.



LINE MARKED BY NOTCH CUT IN BLAZE.

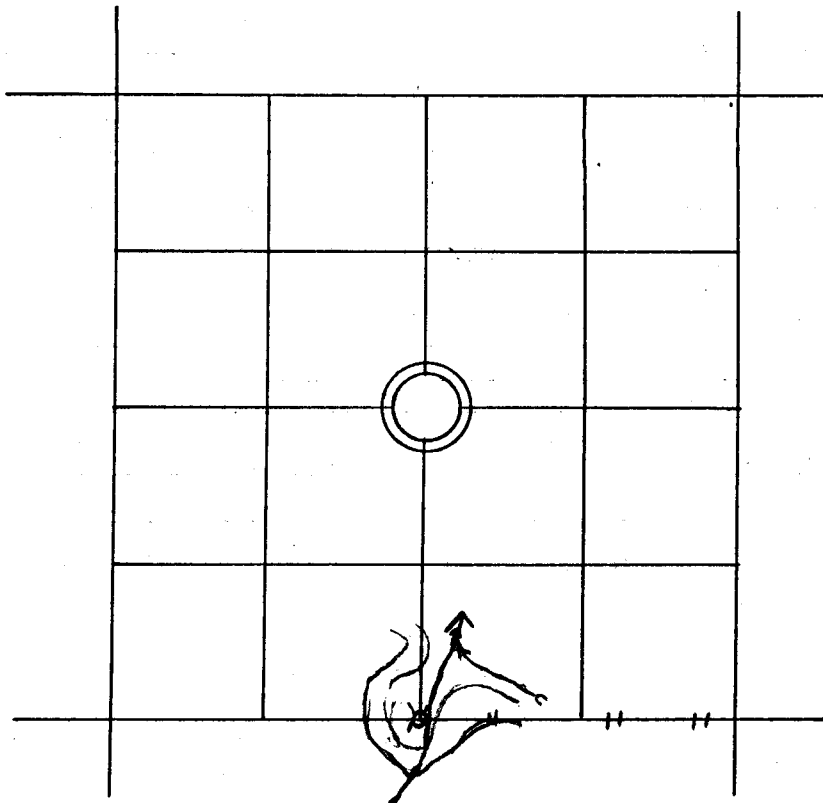

SECTION 4 TOWNSHIP 24S RANGE 3W

ACCESSORIES ADDED THIS DATE:

MAGNETIC DECLINATION 20°

	BEARING	FEET	ORIG. B.T.	"W" NAIL	PLATE	BRASS DISC
26" Cedar	S13W	8.9	X	X	X	
10" Hem	N2E	28.6		X	X	

IDENTIFIED ON PHOTO:

INFORMATION ON LOCATION OF CORNER AS NOW SET:

GROUND COVER: Fern - East bank Coon Creek.

(USING FORM LINES SKETCH TOPOG AT CORNER ON PAGE 2 PLAT)

SLOPE FACES (GIVE BEARING IN DEGREES) West ON MINUS (-) 7 %

NORTH: Virgin Timber along East Side Creek.

FROM CORNER | SOUTH: +109° 80' then + 45°

EAST: +10° through old growth.

WEST: -79° 25' Creek C S 10 W.

WORK DONE FOR W. T. CO.:

FIELD NOTES IN BOOK: \_\_\_\_\_

BY: Allen McChesney  
ENGINEER - SURVEYOR

DATE: 5/16/58

UNDER THE SUPERVISION OF:

ASSISTED BY: \_\_\_\_\_

COPIES SENT TO: \_\_\_\_\_