


# PUBLIC LAND CORNERS

WEYERHAEUSER COMPANY  
SPRINGFIELD BRANCH

TOWNSHIP 24 S RANGE 3 W  
SECTION 10 CORNER W  $\frac{1}{4}$   
COUNTY Douglas OREGON

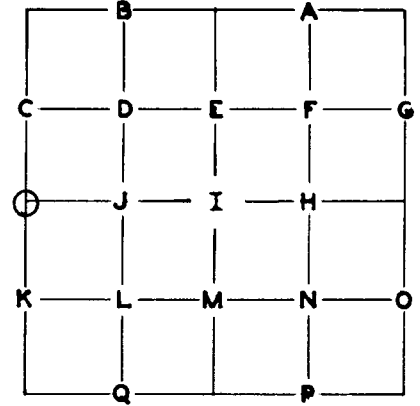

**GLO SURVEY RECORD**

DATE: Aug. 4, '87

CORNER Post

PRESENT CONDITION - (DESCRIBE FULLY - USE PAGE 2 IF NEEDED FOR EXPLANATION.)

Gone

**ACCESSORIES:**

	BEARING-	LINKS-	FEET-	
7" yew	N 20 E	16	10.6	9" Yew, bent over rotted scribing visible. 37" Hem, scribing visible.
24" Hem	N 80 W	12	7.9	

Doug. County **SURVEY RECORD**  
DATE: 1967

PRESENT CONDITION: \_\_\_\_\_

Brass cap  
6" Hem, S 58 W 22.6'  
14" Hem S 64 E 25.1'

CORNER SET: Found Doug. county, brass cap, set yew MAG. DECL.: 20 degrees E post on east side of cap.

**BEARING AND DISTANCE TO ABOVE IDENTIFIED SURVEY ACCESSORIES:**

BEARING-	FEET-	SURVEY -	
37" Hem	7.9	1887	scribing visible, face chopped out
9" Yew	10.6	1887	Bent over face rotted. Scribing not visible.
6" Hem	22.6	1967	S 58 W scribing visible
14" Hem	25.1	1967	S 64 E <u>St 2</u> " 3 M



ACCESSORIES ADDED THIS DATE:

MAGNETIC DECLINATION 20 degrees

	BEARING	FEET	ORIG. B.T.	"W" NAIL	PLATE	BRASS DISC
37" Hem	N 85 W	7.3	/	/	/	
14" Hem	S 64 E	25.1		/	/	

IDENTIFIED ON PHOTO:

INFORMATION ON LOCATION OF CORNER AS NOW SET:

GROUND COVER: Old growth Fir and Hem

(USING FORM LINES SKETCH TOPOG AT CORNER ON PAGE 2 PLAT)

SLOPE FACES (GIVE BEARING IN DEGREES) S 58 W ON MINUS (-) 28 %

NORTH: + 70%

SOUTH: - 25%

EAST: + 60%

WEST: + 25%

FROM CORNER |

WORK DONE FOR W. CO.

FIELD NOTES IN BOOK:

BY: C. Volz ENGINEER - SURVEYOR DATE: 1/13/69

ASSISTED BY: L. Wilson L Warren

COPIES SENT TO: Doug. county survey Files

UNDER THE SUPERVISION OF:

SEAL

e.s. 53/111