


PUBLIC LAND CORNERS

12

7

**WEYERHAEUSER COMPANY
SPRINGFIELD BRANCH**

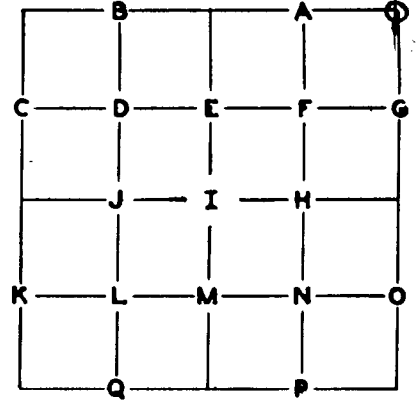

TOWNSHIP 24S RANGE 3W
SECTION 13 CORNER NE
COUNTY Douglas OREGON

GLO SURVEY RECORD

PRESENT CONDITION - (DESCRIBE FULLY - USE PAGE 2 IF NEEDED FOR EXPLANATION.)

DATE: 1883
CORNER Post

Gone

ACCESSORIES:

	BEARING-	LINKS-	FEET-	
12" Maple	N15°E	40	26.4	Chopping, "W" nail but no scribing
36" Fir	S50°E	16	10.6	No evidence
12" Maple	S40°W	10	6.6	No evidence
16" Fir	N45°W	37	24.4	Existing 38" Fir in 1954 - slide from road removed any evidence

Weyerhaeuser Co. SURVEY RECORD

PRESENT CONDITION:

DATE: 1954

38" Fir	N40°W	24.4	Slide no evidence
14" Maple	N15°E	27.2	14" Maple stub 5' high "W" nail but no scribing
52" Fir	S77°E	47.5	Windthrow root wad @ distance -no reference
34" Fir	S59°W	33.0	Slide no evidence

CORNER SET: 1 1/2" x 42" Iron pipe MAG. DECL.: 20°E

BEARING AND DISTANCE TO ABOVE IDENTIFIED SURVEY ACCESSORIES

BEARING-	FEET-	SURVEY -	
N15°E	27.2	1883&1954	Distance measured to "W" nail

ACCESSORIES ADDED THIS DATE:

MAGNETIC DECLINATION 20°E

	BEARING	FEET	ORIG. B.T.	'W' NAIL	PLATE	BRASS DISC
14" Maple stub	N15°E	27.2	x	x	x	-
36" Fir stump	N56°W	37.2	-	x	x	-

IDENTIFIED ON PHOTO:

INFORMATION ON LOCATION OF CORNER AS NOW SET:

GROUND COVER: Logged 1964

(USING FORM LINES SKETCH TOPOG AT CORNER ON PAGE 2 PLAT)

SLOPE FACES (GIVE BEARING IN DEGREES) South ON MINUS (-) 25 %

FROM CORNER |

NORTH: + 25% 90' to Spur 340

SOUTH: - 25%

EAST: Level

WEST: - 35%

WORK DONE FOR W. CO.

FIELD NOTES IN BOOK:

BY: Donald H. Jordan DATE: 12-2-65
Asst. ENGINEER - SURVEYOR

ASSISTED BY: Carl Peters

UNDER THE SUPERVISION OF:

COPIES SENT TO:

SEAL