


PUBLIC LAND CORNERS

Post

WEYERHAEUSER COMPANY
SPRINGFIELD BRANCH

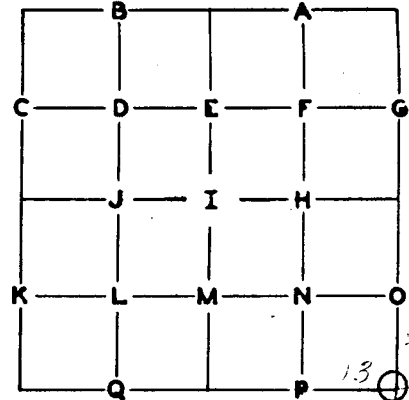

TOWNSHIP 24S RANGE 3W
SECTION 13 CORNER SE
COUNTY Douglas OREGON

GLO SURVEY RECORD
CORNER Post DATE: 1871

PRESENT CONDITION - (DESCRIBE FULLY - USE PAGE 2 IF NEEDED FOR EXPLANATION.)
Gone

ACCESSORIES:

	BEARING-	LINKS-	FEET-
30" Cedar	S30°W	40	26.4
10" Hemlock	N45°W	10	6.6
20" Cedar	N82°E	23	15.2
20" Hemlock	S70°E	35	23.1

44" Cedar face part grown over, no scribing
13" Hem. face open, part rotten, scribing visible
42" Cedar face part grown over, no scribing
32" Hem. tree windthrown, face closed

Weyerhaeuser Co. **SURVEY RECORD**
DATE: 1945

33" Cedar	S29°W	24.8
28" Cedar	N84°E	14.7

PRESENT CONDITION: Post gone

44" Cedar from above description
42" Cedar from above description

CORNER SET: 1" x 30" Aluminum Pipe MAG. DECL.: 20°E

BEARING AND DISTANCE TO ABOVE IDENTIFIED SURVEY ACCESSORIES:

BEARING-	FEET-	SURVEY -	
N83°E	14.0	1871	Distance measured to face
S29°W	24.0	1871	Distance measured to face

ACCESSORIES ADDED THIS DATE:

MAGNETIC DECLINATION 20°E

	BEARING	FEET	ORIG. B.T.	"W" NAIL	PLATE	BRASS DISC
42" Cedar	N83°E	13.6	x	x	x	-
44" Cedar	S29°W	24.0	x	x	x	-
36" Hemlock	N88°W	25.3	-	x	x	-
68" Fir	N28°E	35.9	-	x	x	-

IDENTIFIED ON PHOTO:

INFORMATION ON LOCATION OF CORNER AS NOW SET:

GROUND COVER: Logged 1965

(USING FORM LINES SKETCH TOPOG AT CORNER ON PAGE 2 PLAT)

SLOPE FACES (GIVE BEARING IN DEGREES) S4°W ON MINUS (-) -40 %

NORTH: + 25%

FROM CORNER - SOUTH: - 25% 20' to stream bearing SW

EAST: + 10% 30' to stream bearing SW

WEST: - 35%

WORK DONE FOR W. CO. _____

FIELD NOTES IN BOOK: _____

BY: Donald H. Jordan DATE: 10-8-65
Asst. ENGINEER - SURVEYOR

ASSISTED BY: Harley Case
Bruce Wood

UNDER THE SUPERVISION OF:

COPIES SENT TO: _____