


PUBLIC LAND CORNERS

WEYERHAEUSER TIMBER COMPANY
 SPRINGFIELD BRANCH

TOWNSHIP 24S RANGE 3W
 SECTION 4 CORNER E 1/4
 COUNTY DOUGLAS OREGON

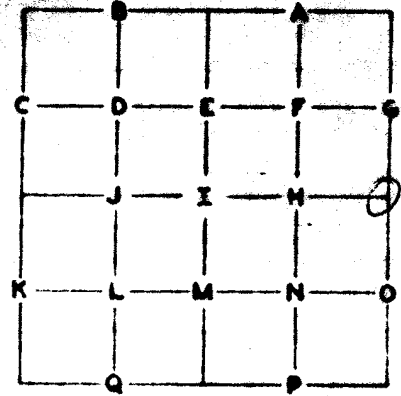

GLO SURVEY RECORD

DATE: 1887

CORNER POST

PRESENT CONDITION - (DESCRIBE FULLY -
 USE PAGE 2 IF NEEDED FOR EXPLANATION.)

Corner never found

ACCESSORIES:

	BEARING-	LINKS-	FEET-
10" Fir	S 19° E	27	
8" Fir	S 31° W	56	

SURVEY RECORD

DATE: _____

PRESENT CONDITION: _____

CORNER SET: Monel pipe

MAGNETIC DECLINATION: 20°

BEARING AND DISTANCE TO ABOVE IDENTIFIED SURVEY ACCESSORIES:

BEARING-	FEET-	SURVEY-

CS 53/111-35

Page 1

ACCESSORIES ADDED THIS DATE:

MAGNETIC DECLINATION _____

	BEARING	FEET	ORIG. B.T.	"W" NAIL	PLATE	BRASS DISC
38" Cedar	N 67° W	27.5		X	X	
28" Hemlock	N 76° E	3.2		X	X	

IDENTIFIED ON PHOTO:

INFORMATION ON LOCATION OF CORNER AS NOW SET:

GROUND COVER: Corner on lower edge of slide - dense W

(USING FORM LINES SKETCH TOPOG AT CORNER ON PAGE 2 PLAT)

SLOPE FACES (GIVE BEARING IN DEGREES) _____ ON MINUS (-) %

FROM CORNER |

NORTH: - 482 Thru O.G. timber, scattered small Hemlock and fine Maple

SOUTH: + 982 45' to top of old slide thru ferns and O.G. timber

EAST: + 427 60' to N55 ridge thru ferns and O.G. timber

WEST: - 152 50' to N55 ridge thru ferns and O.G. timber

WORK DONE FOR W. T. CO.:

FIELD NOTES IN BOOK: _____

BY: Warney
ENGINEER - SURVEYOR

DATE: OCT. 1953

UNDER THE SUPERVISION OF:

ASSISTED BY: W. Warren Dixon

C. Price

) Survey 1953

G. McChesney

COPIES SENT TO: _____

SEAL