


PUBLIC LAND CORNERS

**WEYERHAEUSER TIMBER COMPANY
SPRINGFIELD BRANCH**

TOWNSHIP _____ RANGE 3 W

SECTION _____ CORNER Q

COUNTY DOUGLAS OREGON

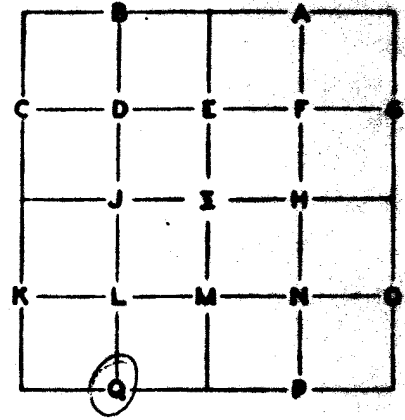

GLO SURVEY RECORD

DATE: _____

CORNER _____

**PRESENT CONDITION - (DESCRIBE FULLY -
USE PAGE 2 IF NEEDED FOR EXPLANATION.)**

ACCESSORIES:

BEARING-	LINKS-	FEET-

W.T.Co. **SURVEY RECORD**
DATE: _____

PRESENT CONDITION: _____

Set 3/4" MONEL PIPE SET 5' I.P. 5' TALL GOOD

CORNER SET: _____ MAGNETIC DECLINATION: _____

BEARING AND DISTANCE TO ABOVE IDENTIFIED SURVEY ACCESSORIES:

BEARING-	FEET-

CS 53/111-36

ACCESSORIES ADDED THIS DATE:

	BEARING-	FEET	ORIG. BT	W ² -NAIL	PLATE	BRASS DISC
5" MAPLE	S 97° W	43.7	X	X		
16" MAPLE	S 23° W	35.7	X	X		

IDENTIFIED ON PHOTO:

INFORMATION ON LOCATION OF CORNER AS NOW SET:

DESCRIPTION OF GROUND COVER AND GROUND SLOPE AT CORNER: SLOPE WEST COVER -

BIG LEAF MAPLE, THIMBLEBERRY & FERN

FROM CORNER NORTH: 52 FOR 60', THEN 117 TO BOTTOM TREX 150'

SOUTH: 162 FOR ABOUT 80' THEN CROSS BOTTOM COON CK. 200'

EAST: 762 FOR ABOUT 100'

WEST: 762 FOR 25' YMERCE LEVEL, 877 CREEK BOTTOM COON CREEK

WORK DONE FOR W. T. CO.

BY: Hake
ENGINEER - SURVEYOR

DATE: OCTOBER 14, 1957

ASSISTED BY: _____

UNDER SUPERVISION OF:

COPIES SENT TO: _____