


PUBLIC LAND CORNERS

WEYERHAEUSER TIMBER COMPANY
 SPRINGFIELD BRANCH

TOWNSHIP 24S RANGE 3 W
 SECTION 15 CORNER E 1
 COUNTY DOUGLAS OREGON

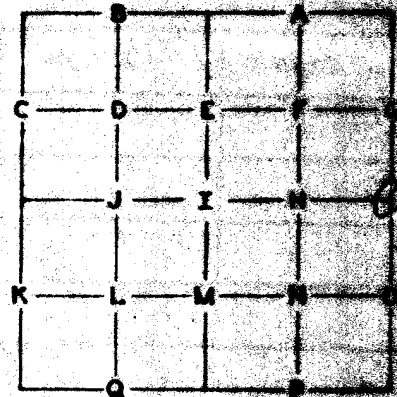

GLO SURVEY RECORD

DATE: 1871

CORNER Post

PRESENT CONDITION - (DESCRIBE FULLY -
 USE PAGE 2 IF NEEDED FOR EXPLANATION)

Never found

ACCESSORIES:

	BEARING-	LINKS-	FEET-
8" Cedar	S 36° E	22	14.5
10" Maple	S 35° W	21	13.8

Never found

Never found

WTC SURVEY RECORD

DATE: 1948

Caider Survey by Ken Bergeson

PRESENT CONDITION: Found 2" cedar

post, center at bottom

22" cedar N 27° W 19.5', plate, brass disc,

& "W" Nail

Good - plate about grown out.

36" Cedar S 1° W 10.2', plate, brass disc,

& "W" Nail

Good - plate about grown out.

CORNER SET: 3/4" x 3/4" Metal Pipe

MAGNETIC DECLINATION: 20° E

November, 1900

BEARING AND DISTANCE TO ABOVE IDENTIFIED SURVEY ACCESSORIES:

BEARING-	FEET-	SURVEY-
<u>SEE ACCESSORIES</u>	<u>ADDED THIS DATE</u>	

CS 53/III-37

ACCESSORIES ADDED THIS DATE

MAGNETIC DEVIATION 20° E

This record supersedes previous WT references.

	BEARING	FEET	ORIG. B.T.	"W" NAIL	PLATE	BRASS DISC
22" Cedar	N 27° W	49.0	1948 WT Ref	X	X	X
36" Cedar	S 1° W	69.7	1948 WT Ref	X	X	X

IDENTIFIED ON PHOTO:

INFORMATION ON LOCATION OF CORNER AS NOW SET.

GROUND COVER: Old growth fir, maple, haw, and sapling fir

(USING FORM LINES SKETCH TOPOG AT CORNER ON PAGE 2 PLAT)

SLOPE FACES (GIVE BEARING IN DEGREES) West ON MINUS (-) 35%

NORTH: 4 50 feet 100 feet

FROM CORNER | SOUTH: Level for 50 feet, thence +20% up over ridge.

EAST: +6%

WEST: -25% for 50 feet left bank of a fork of Calapuya Creek, course down stream S 30° W up stream N 5° W

WORK DONE FOR W.T. 100

FIELD NOTES BY TOOP

BY: *Hale*
ENGINEER - CIVIL

DATE: 1/1/50 UNDER THE SUPERVISION OF

ASSISTED BY: Harley Eldor Case

COPIES SENT TO

SEAL