


PUBLIC LAND CORNERS

WEYERHAEUSER TIMBER COMPANY
 SPRINGFIELD BRANCH

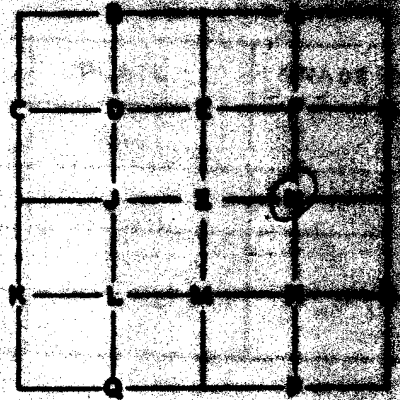

TOWNSHIP 24 S RANGE 3 W
 SECTION 17 CORNER SE 1/16
 COUNTY _____ OREGON

GLO SURVEY RECORD

PRESENT CONDITION - (DESCRIBE FULLY)

DATE: _____
 CORNER _____

ACCESSORIES:

BEARING-	LINKS-	FEET-

SURVEY RECORD
 DATE: _____

PRESENT CONDITION: _____

CORNER SET: WING LOCK STAKE MAGNETIC DECLINATION: 20'

BEARING AND DISTANCE TO ABOVE IDENTIFIED SURVEY ACCESSORIES:

BEARING-	FEET-

CS 53/111-39

ACCESSORIES ADDED THIS DATE:

	BEARING -	FEET -	"W" NAIL -	PLATE -	BRASS DISC -
34" FIR	S 63° W	13.5	X	X	
7" FIR	N 10° E	8.9	X	X	

IDENTIFIED ON PHOTO:

INFORMATION ON LOCATION OF CORNER AS NOW SET:
 DESCRIPTION OF GROUND COVER AND GROUND SLOPE AT CORNER: _____

FROM CORNER NORTH: _____

SOUTH: _____

EAST: _____

WEST: _____

WORK DONE FOR W. T. CO.

BY: Hale Mason W. Hale
 ENGINEER - SURVEYOR

DATE: JANUARY 1956

ASSISTED BY: _____

UNDER SUPERVISION OF: _____

COPIES SENT TO: _____

SEAL