


PUBLIC LAND CORNER

WEYERHAEUSER COMPANY
 SPRINGFIELD BRANCH

*1964 Cadastral
 Recovery*

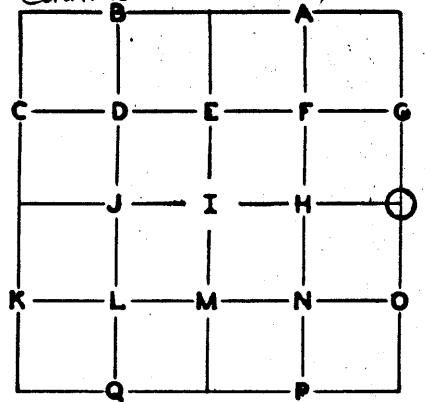

TOWNSHIP 25S RANGE 2W
 SECTION 4 CORNER E $\frac{1}{2}$
 COUNTY Douglas OREGON

GLO SURVEY RECORD

PRESENT CONDITION - (DESCRIBE FULLY -
 USE PAGE 2 IF NEEDED FOR EXPLANATION.)

DATE: _____
 CORNER See Page 2

ACCESSORIES:

BEARING-	LINKS-	FEET-

SURVEY RECORD
 DATE: _____


PRESENT CONDITION: _____

CORNER SET: Stone and 1951 brass cap as found MAG. DECL.: 20° E

BEARING AND DISTANCE TO ABOVE IDENTIFIED SURVEY ACCESSORIES:

BEARING-	FEET-	SURVEY -	
N42W	2.0	orig.	distance to face
S56E	15.4	orig.	distance to face
S47E	26.5	1951	distance to face

SECTION 4 TOWNSHIP 25S RANGE 2W

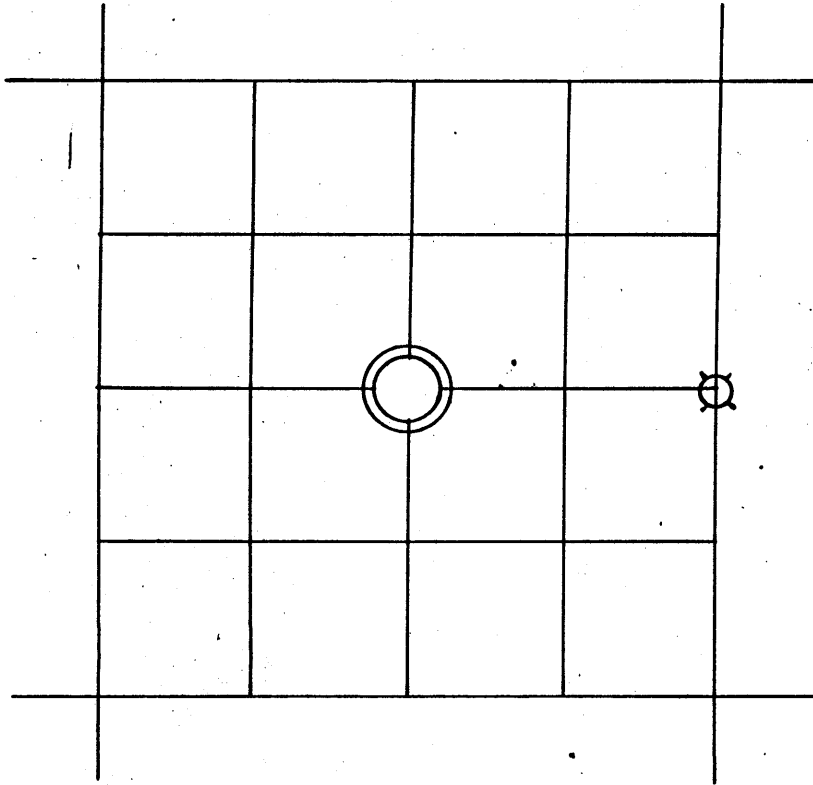

— // — // — // — LINE MARKED BY NOTCH CUT IN BLAZE.

○ — — — KNOWN CORNER.

⊗ — — — REFERENCED CORNER
BY WEYERHAEUSER
METHOD.

GL0 record - 1951	-	found 8/2/65 G.Mc
Found original stone		
Found original Bts:		
26" Hem. N42W 31ks.	:	found - face healed over
(recorded distance 21ks.)		
8" Hemlock S56E 24ks.	-	scribing visible - 8" Hemlock
Set Brass Cap	-	found
New BT:		
38" Hemlock S47E 431ks.	-	found 32" Hem. scribing visible

ACCESSORIES ADDED THIS DATE:

MAGNETIC DECLINATION 20°

	BEARING	FEET	ORIG. B.T.	"W" NAIL	PLATE	BRASS DISC
54" Fir	S69W	17.5	-	x	x	-
32" Hemlock	S46E	26.0	-	x	x	-

IDENTIFIED ON PHOTO:

INFORMATION ON LOCATION OF CORNER AS NOW SET:

GROUND COVER: Virgin -

(USING FORM LINES SKETCH TOPOG AT CORNER ON PAGE 2 PLAT)

SLOPE FACES (GIVE BEARING IN DEGREES) _____ ON MINUS (-) %

NORTH: - 75%

SOUTH: + 60%

EAST: - 15% for 25' then rock knob

WEST: - 23% for 80' then descent steepens

FROM CORNER -

WORK DONE FOR W. CO. _____

FIELD NOTES IN BOOK: _____

BY: Alex McClesney DATE: 8/2/65
 ENGINEER & SURVEYOR
 Land Agent
 ASSISTED BY: Eldon Case

UNDER THE SUPERVISION OF:

COPIES SENT TO: _____