


# PUBLIC LAND CORNERS

**WEYERHAEUSER COMPANY  
SPRINGFIELD BRANCH**

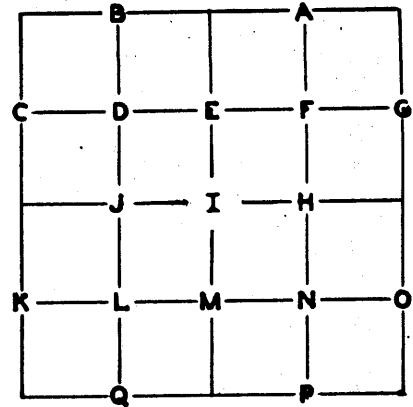

TOWNSHIP 25S RANGE 2W  
 SECTION 4 CORNER SE Cor. Parcel 41  
 COUNTY Douglas OREGON

**GLO SURVEY RECORD**

DATE: \_\_\_\_\_

CORNER \_\_\_\_\_

**ACCESSORIES:**

BEARING-	LINKS-	FEET-

**PRESENT CONDITION - (DESCRIBE FULLY - USE PAGE 2 IF NEEDED FOR EXPLANATION.)**

**SURVEY RECORD**

DATE: \_\_\_\_\_

Civil No. 60-135

Set 3/4" Iron pipe

8" Fir - S61 1/4 W 46 lks.

9" Fir - N4 3/4 W 69 lks.

**PRESENT CONDITION:** \_\_\_\_\_

Found

8" Hemlock (not Fir) scribing visible

8" Hemlock (not Fir) scribing visible

CORNER SET: Pipe as found MAG. DECL.: 20°

**BEARING AND DISTANCE TO ABOVE IDENTIFIED SURVEY ACCESSORIES:**

BEARING-	FEET-	SURVEY -
S62W	30.0	to face
N4W	45.1	to face

ACCESSORIES ADDED THIS DATE:

MAGNETIC DECLINATION

20°

	BEARING	FEET	ORIG. B.T.	"W" NAIL	PLATE	BRASS DISC
22" Red Cedar	N78W	31.6	-	x	x	-
34" Red Cedar	S14W	41.4	-	x	x	

IDENTIFIED ON PHOTO:

INFORMATION ON LOCATION OF CORNER AS NOW SET:

GROUND COVER: Old growth

(USING FORM LINES SKETCH TOPOG AT CORNER ON PAGE 2 PLAT)

SLOPE FACES (GIVE BEARING IN DEGREES) ON MINUS (-) %

NORTH: Level

SOUTH: + 35

EAST: + 88%

WEST: - 57%

FROM CORNER |

WORK DONE FOR W. CO.

FIELD NOTES IN BOOK:

BY: Glen McChesney DATE: 8/2/65  
**ENGINEER-SURVEYOR**  
 Land Agent

ASSISTED BY: Elden Case

COPIES SENT TO:

UNDER THE SUPERVISION OF: