


PUBLIC LAND CORNERS

WEYERHAEUSER COMPANY
 SPRINGFIELD BRANCH

TOWNSHIP 25S RANGE 2W
 SECTION 12 CORNER W $\frac{1}{2}$
 COUNTY Douglas OREGON

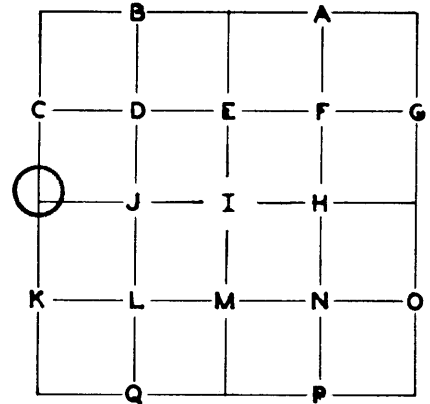

GLO SURVEY RECORD

DATE: 1900
 CORNER Stone 18" x 10" x 6"

PRESENT CONDITION - (DESCRIBE FULLY -
 USE PAGE 2 IF NEEDED FOR EXPLANATION.)

No trace

ACCESSORIES:

	BEARING-	LINKS-	FEET-
7" Maple	N55 E	7	4.6
24" Arbutus	N38 W	12	7.9

No trace

No trace

V. Hosford SURVEY RECORD
 DATE: 10/16/57

PRESENT CONDITION: _____

C. S. File No. 42/308
 Corner point re-established in its original
 position from transit line.
 Set 1 $\frac{1}{2}$ " iron pipe
 Marked two new BIs:
 40" Fir S64 $\frac{1}{2}$ E 23.7'
 18" Incense Cedar S71 $\frac{1}{2}$ W 81.1'

Found - plug and hub-tack in pipe

42" Fir - Scribing Visible

22" Incense Cedar - Scribing Visible

CORNER SET: Hosford pipe as found

MAG. DECL.: 20°

BEARING AND DISTANCE TO ABOVE IDENTIFIED SURVEY ACCESSORIES:

BEARING-	FEET-	SURVEY-
S 65 E	23.7	1957
S 71 $\frac{1}{2}$ W	81.1	1957

Distance measured to face

Distance measured to face

CS 53/12-18

ACCESSORIES ADDED THIS DATE:

MAGNETIC DECLINATION

20°

	BEARING	FEET	ORIG. B.T.	"W" NAIL	PLATE	BRASS DISC
42" Fir	S 65 E	23.2	1957	X	X	-
22" Incense Cedar	S 72 W	81.1	"	X	X	-

IDENTIFIED ON PHOTO:

INFORMATION ON LOCATION OF CORNER AS NOW SET:

GROUND COVER: Old logging-brush

(USING FORM LINES SKETCH TOPOG AT CORNER ON PAGE 2 PLAT)

SLOPE FACES (GIVE BEARING IN DEGREES) S 60 W ON MINUS (-) 50 %

NORTH: + 15% 20' to rock out crop

SOUTH: -15% 30' then descent steepens

EAST: + 72% approximately 220' to dirt spur

WEST: - 50% 25' to draw C-s

FROM CORNER -

WORK DONE FOR W. CO.

FIELD NOTES IN BOOK:

BY: Glen McChesney DATE: 7/28/70

~~FORWARD - CORNER~~

ASSISTED BY:

UNDER THE SUPERVISION OF:

COPIES SENT TO:

SEAL

PAGE 3

File No.