


PUBLIC LAND CORNER

WEYERHAEUSER TIMBER COMPANY
 SPRINGFIELD BRANCH

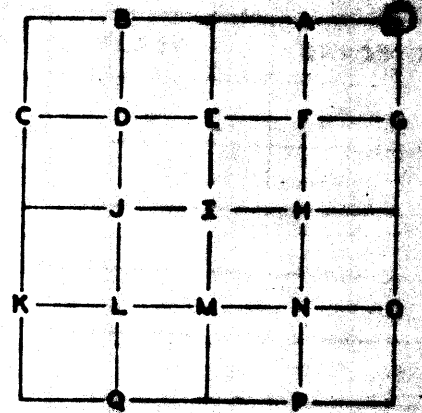

TOWNSHIP 25 S RANGE 2 W

SECTION 14 CORNER NE

COUNTY DOUGLAS OREGON

GLO SURVEY RECORD

DATE: _____
 CORNER Stone

PRESENT CONDITION - (DESCRIBE FULLY -
 USE PAGE 2 IF NEEDED FOR EXPLANATION)

In Position

ACCESSORIES:

	BEARING-	LINKS-	FEET-	
<u>38" Flr</u>	<u>N 25° E</u>	<u>11</u>	<u>27.1</u>	<u>Green - Face not Chopped 40" Flr</u>
<u>14" Flr</u>	<u>S 33° E</u>	<u>15</u>	<u>9.9</u>	<u>50" Flr. Face Not Chopped</u>
<u>14" Flr</u>	<u>S 55° W</u>	<u>31</u>	<u>20.5</u>	<u>25" Snag Scouting Visible</u>
<u>14" Hem</u>	<u>N 76° W</u>	<u>26</u>	<u>17.2</u>	<u>18" Hem. Scouting Visible</u>

SURVEY RECORD
 DATE: _____

PRESENT CONDITION: _____

CORNER SET: Found Stone & 4" Ced. Post MAGNETIC DECLINATION: 20°

BEARING AND DISTANCE TO ABOVE IDENTIFIED SURVEY ACCESSORIES:

BEARING-	FEET-	SURVEY -
<u>N 21° E</u>	<u>27.1</u>	<u>GLO</u>
<u>S 24° E</u>	<u>9.9</u>	<u>GLO</u>
<u>S 51° W</u>	<u>19.9</u>	<u>GLO</u>
<u>N 76° W</u>	<u>17.4</u>	<u>GLO</u>

ACCESSORIES ADDED THIS DATE:

MAGNETIC DECLINATION 20°

	BEARING	FEET	ORIG. B.T.	"W" NAIL	PLATE	BRASS DISC
38" Fir	N 21° E	26.0	x	x	x	
50" Fir	S 25° E	9.4	x	x	x	
38" Cedar	S 76° W	22.0		x	x	
14" Fir Stump	N 33° W	18.0		x	x	

IDENTIFIED ON PHOTO:

INFORMATION ON LOCATION OF CORNER AS NOW SET:

GROUND COVER: Salal, west side fir windfall.

(USING FORM LINES SKETCH TOPOG AT CORNER ON PAGE 2 PLAT)

SLOPE FACES (GIVE BEARING IN DEGREES) n 45° e ON MINUS (-) 80 %

NORTH: - 45% approx 250' Rock Creek

FROM CORNER ↓

SOUTH: +45% 80' timber to West, to be logged 1958 to east.

EAST: -45% 150' Rock Creek

WEST: +30% Logged to North, Timbered to South

WORK DONE FOR W. T. CO.:

Glen Mc Chesney

FIELD NOTES IN BOOK: _____

BY: _____
ENGINEER - SURVEYOR

DATE: 1/30/58

UNDER THE SUPERVISION OF:

ASSISTED BY: _____

COPIES SENT TO: _____

SEAL