


PUBLIC LAND CORNERS

**WEYERHAEUSER TIMBER COMPANY
SPRINGFIELD BRANCH**

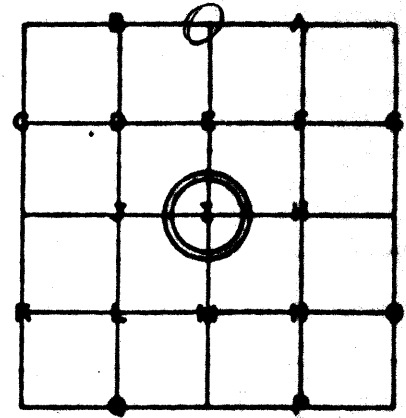

TOWNSHIP 25 S RANGE 2 W
SECTION 20 CORNER N 1/4
COUNTY DOUGLAS OREGON

GLO SURVEY RECORD

PRESENT CONDITION - (DESCRIBE FULLY)

CORNER DATE: Stone Not Found - Steep Sidhill - Slide

ACCESSORIES:

	BEARING-	CHAINS-	FEET-	
1 1/2" Maple	N 69° W	.14	9.2	Found - OK
2 1/2" Fir	S 68° W	.11	7.3	Found - OK

SURVEY RECORD

PRESENT CONDITION:

DATE:

CORNER SET: Post MAGNETIC DECLINATION: 20°

Set by Called Dist. and Bearing from GLO Original Notes -

BEARING AND DISTANCE TO ABOVE IDENTIFIED SURVEY ACCESSORIES:

BEARING-	FEET-	
		Same as Original

CS 53/112-25

ACCESSORIES ADDED THIS DATE:

	BEARING -	FEET -	"W" NAIL -	PLATE -	BRASS DISC -
44" Fir St	N 84 E	23.5	X	X	
28" Fir (Orig BT)	S 72 W	7.0	X	X	

IDENTIFIED ON PHOTO:

INFORMATION ON LOCATION OF CORNER AS NOW SET:

DESCRIPTION OF GROUND COVER AT CORNER: Burned - barren ground

FROM CORNER NORTH: Ascend to East, recent log - West old logging

SOUTH: West, green timber - East, logged, burned

EAST: logged + burned

WEST: South, green timber; North, recently logged
red and yellow tog on 6" Hem on East bank Doug
Co. Lbr Co rd "Approx. 300' E to N 1/4 Cor"

WORK DONE FOR W. T. CO.

BY: [Signature]
ENGINEER - SURVEYOR

DATE: February 27, 1955

ASSISTED BY: _____

UNDER SUPERVISION OF:

COPIES SENT TO: _____

