


PUBLIC LAND CORNERS

**WEYERHAEUSER TIMBER COMPANY
SPRINGFIELD BRANCH**

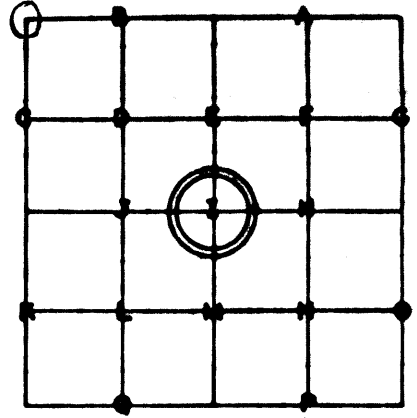

TOWNSHIP 25 S RANGE 2 W
 SECTION 20 CORNER Witness to NW
 COUNTY DOUGLAS OREGON

GLO SURVEY RECORD			
DATE: _____			
CORNER <u>Stone for WC is 13.2' W of NW cor.</u>			
ACCESSORIES:			
BEARING-	CHAINS-	FEET-	

PRESENT CONDITION - (DESCRIBE FULLY)

Found - Marked WC - in place

BT's to NW, NE, SE good condition

Dogwood BT to SW down, rotted.

NW corner would be on rock bluff below WC.

SURVEY RECORD			
DATE: _____			

PRESENT CONDITION: _____

CORNER SET: Stone MAGNETIC DECLINATION: 20°

Stone checked for distance and bearings

BEARING AND DISTANCE TO ABOVE IDENTIFIED SURVEY ACCESSORIES:

BEARING-	FEET-	

ACCESSORIES ADDED THIS DATE:

	BEARING -	FEET -	"W" NAIL -	PLATE -	BRASS DISC -
38" Fir (Orig. BT)	N 16° E	5	X	X	
40" Fir (Orig. BT)	S 44° E	11.6	X	X	
12" Hem.	S 30° W	30.5	X	X	
8" Hem. (Orig. BT)	N 52° W	24.6	X	X	

IDENTIFIED ON PHOTO:

INFORMATION ON LOCATION OF CORNER AS NOW SET:
 DESCRIPTION OF GROUND COVER AT CORNER: Old Growth - West 20' of Rock Bluff

FROM CORNER NORTH: Green Timber

SOUTH: Green Timber

EAST: Descend down bluff - Green Timber

WEST: Green Timber & Ascend

WORK DONE FOR W. T. CO.

BY: _____
 ENGINEER - SURVEYOR

DATE: February 28, 19

ASSISTED BY: _____

UNDER SUPERVISION OF:

COPIES SENT TO: _____

SEAL