


PUBLIC LAND CORNERS

WEYERHAEUSER TIMBER COMPANY
 SPRINGFIELD BRANCH

TOWNSHIP 25S RANGE 2W
 SECTION 22 CORNER E 1/4
 COUNTY Douglas OREGON

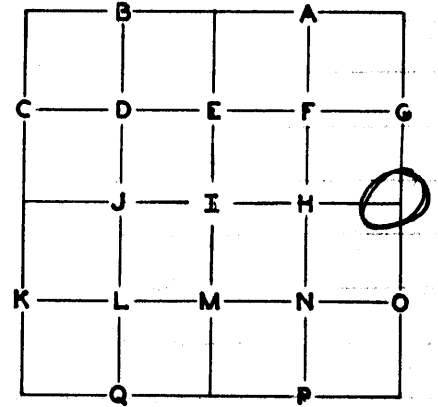

GLO SURVEY RECORD

CORNER Stone DATE: 1900

PRESENT CONDITION - (DESCRIBE FULLY - USE PAGE 2 IF NEEDED FOR EXPLANATION.)

Found.

ACCESSORIES:

BEARING-	LINKS-	FEET-	
<u>16" Ced</u>	<u>N40E</u>	<u>24</u>	<u>15.8</u>
<u>7" Hem</u>	<u>S55W</u>	<u>12</u>	<u>7.9</u>

Down.
14" Hem. scribing visible

CS SURVEY RECORD
 DATE: 1958

PRESENT CONDITION: _____

Found Brass Cap Set 1958
by Douglas County Surveyor.
52" Fir Stump - S79°E - 36.7' scribed "CSBT"
10" Hemlock - S85°W - 39.3' Scribed "CSBT"

CORNER SET: Found Original Stone and brass MAG. DECL: 20'
cap set by Douglas County 1958.

BEARING AND DISTANCE TO ABOVE IDENTIFIED SURVEY ACCESSORIES:

BEARING-	FEET-	SURVEY -	
<u>S65W</u>	<u>7.9</u>	<u>GLO</u>	<u>14" Hem.</u>
<u>From Brass Cap:</u>			
<u>S79E</u>	<u>36.7'</u>	<u>1958</u>	<u>52" Fir Stump CSBT</u>
<u>S85W</u>	<u>39.3'</u>	<u>1958</u>	<u>10" Hem. CSBT</u>

CS 53/112-29

ACCESSORIES ADDED THIS DATE:

MAGNETIC DECLINATION

20°

	BEARING	FEET	ORIG. B.T.	"W" NAIL	PLATE	BRASS DISC
52" Fir Stamp	S 77 E	36.5	CS	X	X	—
52" Fir	N 50 W	19.5	—	X	X	—

IDENTIFIED ON PHOTO:

INFORMATION ON LOCATION OF CORNER AS NOW SET:

GROUND COVER: Oregon Grape

(USING FORM LINES SKETCH TOPOG AT CORNER ON PAGE 2 PLAT)

SLOPE FACES (GIVE BEARING IN DEGREES) N 5 E ON MINUS (-) 46 %

NORTH: -46% 150' cr. c NW

SOUTH: +50% 140' then steepens 200' to rock road

EAST: +7% 40'; -48% 100' cr. c NW

WEST: Level 25'; +34% 25'; -50% 45' cr. c NW

WORK DONE FOR W. T. CO.:

FIELD NOTES IN BOOK:

BY: Glen Mc Chesney
ENGINEER - SURVEYOR

DATE: Aug 1, 1958

UNDER THE SUPERVISION OF:

ASSISTED BY:

COPIES SENT TO:

SEAL