


PUBLIC LAND CORNERS

WEYERHAEUSER TIMBER COMPANY
 SPRINGFIELD BRANCH

TOWNSHIP 25S RANGE 2W
 SECTION 22 CORNER S 1/4
 COUNTY Douglas OREGON

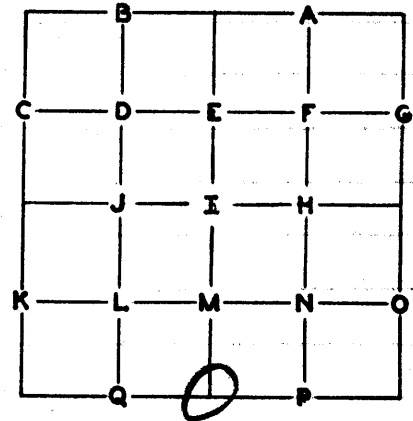

GLO SURVEY RECORD

DATE: 1900
 CORNER Stone

PRESENT CONDITION - (DESCRIBE FULLY - USE PAGE 2 IF NEEDED FOR EXPLANATION.)

Found

ACCESSORIES:

	BEARING-	LINKS-	FEET-	
<u>14" Hem</u>	<u>N34°W</u>	<u>26</u>	<u>1701</u>	<u>Down, badly rotted.</u>
<u>10" Cedar</u>	<u>S22°E</u>	<u>21</u>	<u>1309</u>	<u>14" Cedar, scribing visible. Lower face rotted.</u>

SURVEY RECORD
 DATE: _____

PRESENT CONDITION: _____


CORNER SET: Stone in Place MAG. DECL: 20

BEARING AND DISTANCE TO ABOVE IDENTIFIED SURVEY ACCESSORIES:

BEARING-	FEET-	SURVEY -	
<u>S24°E</u>	<u>13.9</u>	<u>GLO</u>	<u>14" Cedar</u>


CS 53/112-30

SECTION 22 TOWNSHIP 255 RANGE 2W

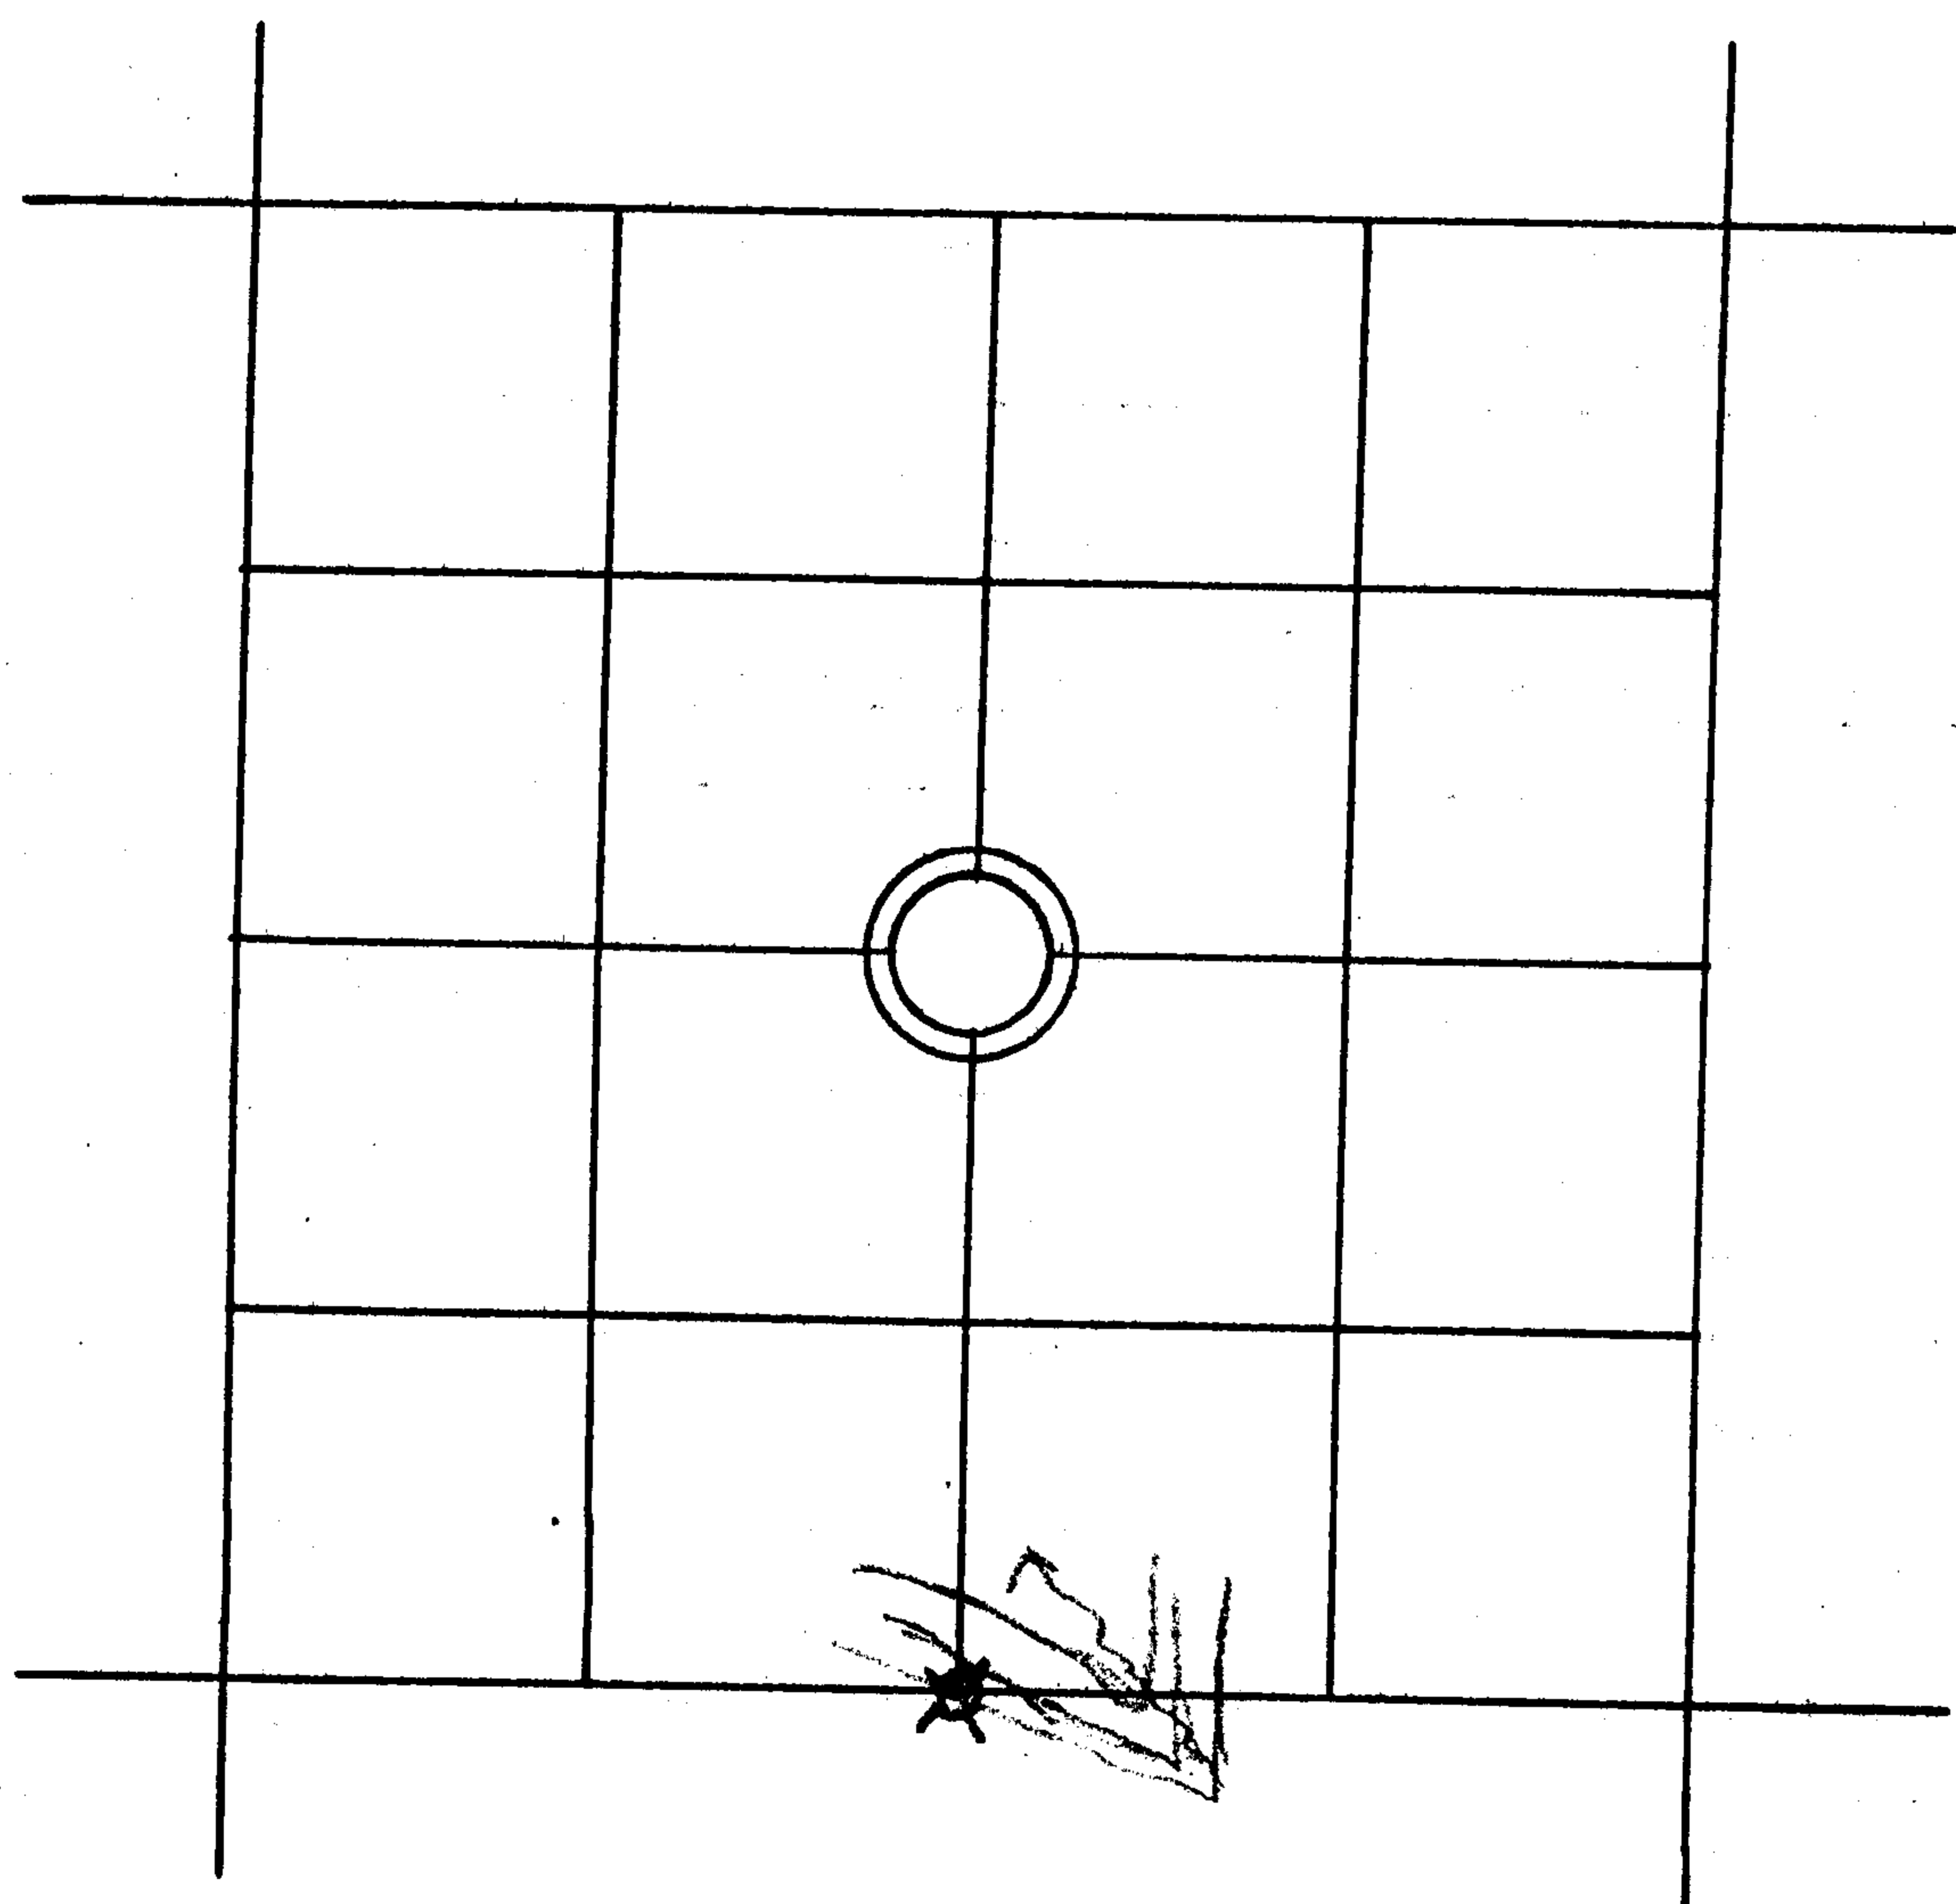

 LINE MARKED BY NOTCH CUT IN BLAZE.

 --- KNOWN CORNER.

 --- REFERENCED CORNER
BY WEYERHAEUSER
METHOD.

ACCESSORIES ADDED THIS DATE:

MAGNETIC DECLINATION 20°

	BEARING	FEET	ORIG. B.T.	"W" NAIL	PLATE	BRASS DISC
44" Fir Stamp 6' high	S38 W	4.0	—	X	X	—
8" Cedar	N41 W	20.6	—	X	X	—

IDENTIFIED ON PHOTO:

INFORMATION ON LOCATION OF CORNER AS NOW SET:

GROUND COVER: Sala

(USING FORM LINES SKETCH TOPOG AT CORNER ON PAGE 2 PLAT)

SLOPE FACES (GIVE BEARING IN DEGREES) N 60 E ON MINUS (-) 7.0 %

NORTH: - 45° 0'. Old growth to East and West.

SOUTH: + 55° 0'. Logged to East and West 1958.

EAST: - 64° 0' 160' cr CNW. Logged to Creek on South, Old growth to North.

WEST: + 60° 0' 20'. Logged to South, Old growth to North.

WORK DONE FOR W. T. CO.:

FIELD NOTES IN BOOK:

BY: Glen McChesney DATE: July 31, 1958
ENGINEER - SURVEYOR

UNDER THE SUPERVISION OF:

ASSISTED BY:

COPIES SENT TO: