


# PUBLIC LAND CORNERS

WEYERHAEUSER TIMBER COMPANY  
 SPRINGFIELD BRANCH

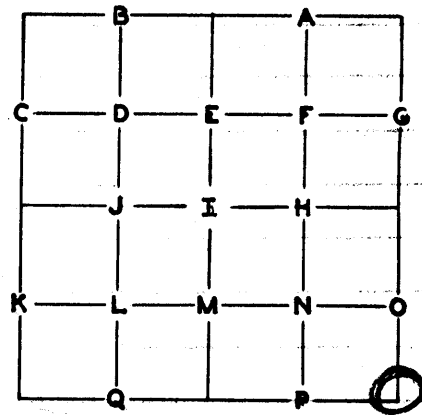

TOWNSHIP 25S RANGE 2W  
 SECTION 22 CORNER SE  
 COUNTY Douglas OREGON

**GLO SURVEY RECORD**

DATE: 1900  
 CORNER Stone

PRESENT CONDITION - (DESCRIBE FULLY -  
 USE PAGE 2 IF NEEDED FOR EXPLANATION.)

Possibly original

**ACCESSORIES:**

	BEARING-	LINKS-	FEET-	
<u>60" Pine</u>	<u>N37E</u>	<u>59</u>	<u>38.9</u>	<u>60" Sugar pine. Face not opened.</u>
<u>30" Fir</u>	<u>S25E</u>	<u>32</u>	<u>21.1</u>	<u>30" Fir. Two faces, not chopped.</u>
<u>18" Fir</u>	<u>S31W</u>	<u>51</u>	<u>33.7</u>	<u>Down, scribing visible.</u>
<u>26" Fir</u>	<u>N44W</u>	<u>59</u>	<u>38.9</u>	<u>32" Fir. Face not chopped out.</u>

C.S. SURVEY RECORD  
 DATE: 1958

PRESENT CONDITION:

Found 1958 Brass cap set by Douglas County.  
4" HEM. - S82°W - 22' - Scribed "CSBT".

CORNER SET: Brass cap in place MAG. DECL: 20°


**BEARING AND DISTANCE TO ABOVE IDENTIFIED SURVEY ACCESSORIES:**

BEARING-	FEET-	SURVEY -	
<u>N37E</u>	<u>38.2</u>	<u>Orig.</u>	<u>60" Sugar pine.</u>
<u>S26E</u>	<u>21.1</u>	<u>"</u>	<u>30" Fir.</u>
<u>S31W</u>	<u>34</u>	<u>"</u>	<u>Down Fir.</u>
<u>N44W</u>	<u>37.2</u>	<u>"</u>	<u>32" Fir.</u>
<u>S82W</u>	<u>22.0</u>	<u>C.S.</u>	<u>4" Hemlock</u>

CS53/112-31


12

SECTION 22 TOWNSHIP 25S RANGE 2W

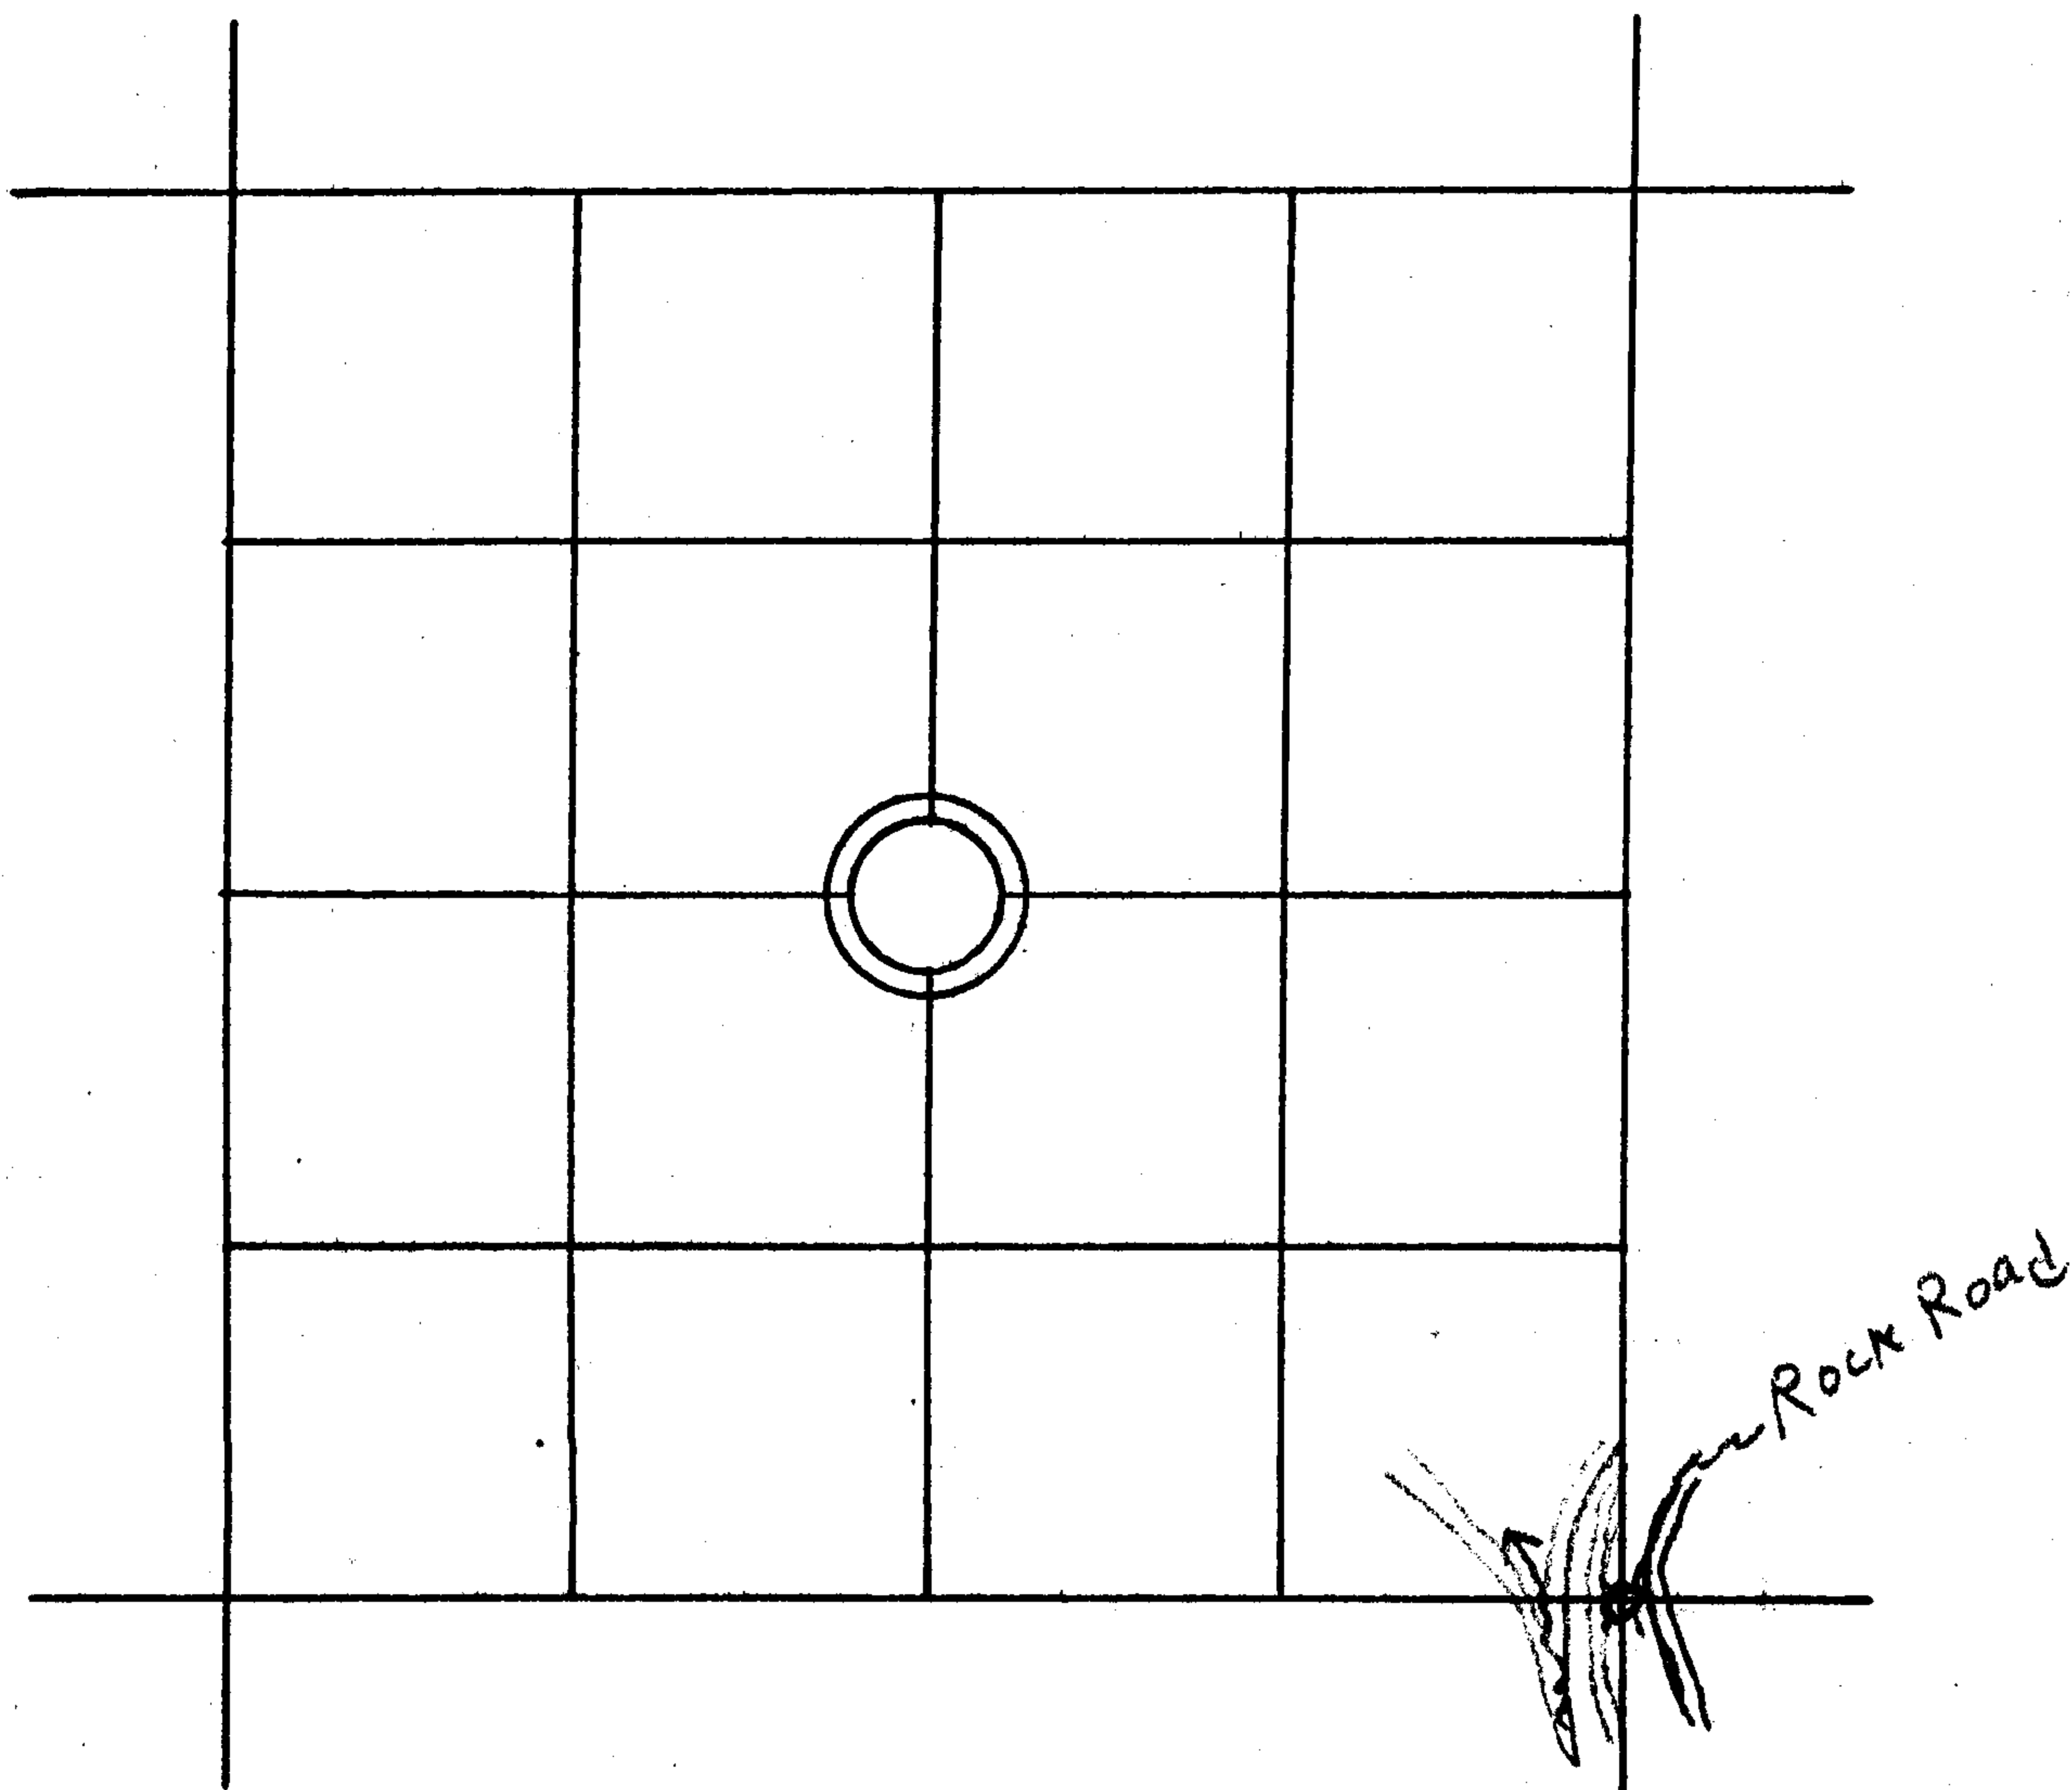

 LINE MARKED BY NOTCH CUT IN BLAZE.

 --- KNOWN CORNER.

 --- REFERENCED CORNER  
BY WEYERHAEUSER  
METHOD.

ACCESSORIES ADDED THIS DATE:

MAGNETIC DECLINATION

20°

	BEARING	FEET	ORIG. B.T.	"W" NAIL	PLATE	BRASS DISC
60" Sugar Pine	N37E	37.6	X	X	X	—
30" Fir	S27E	21.0	X	X	X	—
4" Hem.	S82W	22.0	C S	X	X	—
32" Fir	N43W	36.2	X	X	X	—

IDENTIFIED ON PHOTO:

INFORMATION ON LOCATION OF CORNER AS NOW SET:

GROUND COVER: Sisal, Rhododendron

(USING FORM LINES SKETCH TOPOG AT CORNER ON PAGE 2 PLAT)

SLOPE FACES (GIVE BEARING IN DEGREES) N85°W ON MINUS (-) 7.4 %

NORTH: -167° 0' old growth to West and logged R/W to East.

SOUTH: +157° 40' Logged to West and R/W logged to East.

EAST: +667° 55' to rock road.

WEST: -747° 330' Cr. CN. Logged to South, old growth to North.

FROM CORNER -

WORK DONE FOR W. T. CO.:

FIELD NOTES IN BOOK:

BY: Glen Mc Chesney  
ENGINEER - SURVEYOR

DATE: Aug 1, 1958

UNDER THE SUPERVISION OF:

ASSISTED BY:

COPIES SENT TO:

SEAL

PAGE 3