


# PUBLIC LAND CORNERS

WEYERHAEUSER TIMBER COMPANY  
SPRINGFIELD BRANCH

TOWNSHIP 25S RANGE 2W  
SECTION 22 CORNER SW  
COUNTY Douglas OREGON

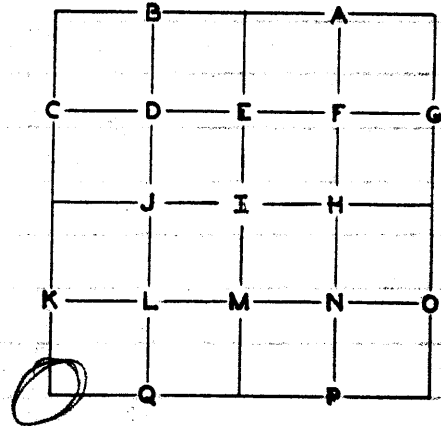

<b>GLO SURVEY RECORD</b> DATE: <u>1900</u> CORNER <u>Stone</u>	<b>PRESENT CONDITION - (DESCRIBE FULLY - USE PAGE 2 IF NEEDED FOR EXPLANATION.)</b> <u>Found</u>
--	---

ACCESSORIES:				
	BEARING-	LINKS-	FEET-	
<u>5" Hemlock</u>	<u>N12 1/2 E</u>	<u>31</u>	<u>20.5</u>	<u>14" Hem. Face.</u>
<u>6" Arbutus</u>	<u>S80 E</u>	<u>14</u>	<u>9.2</u>	<u>Gone.</u>
<u>8" Chingwapim</u>	<u>S42 W</u>	<u>14</u>	<u>9.2</u>	<u>14" Ching. Face not opened.</u>
<u>20" Fir</u>	<u>N75 W</u>	<u>51</u>	<u>33.7</u>	<u>32" Fir. Face.</u>

<b>SURVEY RECORD</b> DATE: _____	<b>PRESENT CONDITION:</b> _____
-------------------------------------	---------------------------------

CORNER SET: Original Stone MAG. DECL: 20°


**BEARING AND DISTANCE TO ABOVE IDENTIFIED SURVEY ACCESSORIES:**

BEARING-	FEET-	SURVEY -	
<u>N 11 E</u>	<u>20.5</u>	<u>GLO</u>	<u>14" Hem.</u>
<u>S39 W</u>	<u>9.2</u>	<u>GLO</u>	<u>14" Chingwapim</u>
<u>N74 W</u>	<u>33.7</u>	<u>GLO</u>	<u>32" Fir.</u>

CS 93/112 - 32

LAND RECORDS

SECTION 22 TOWNSHIP 25S RANGE 2W

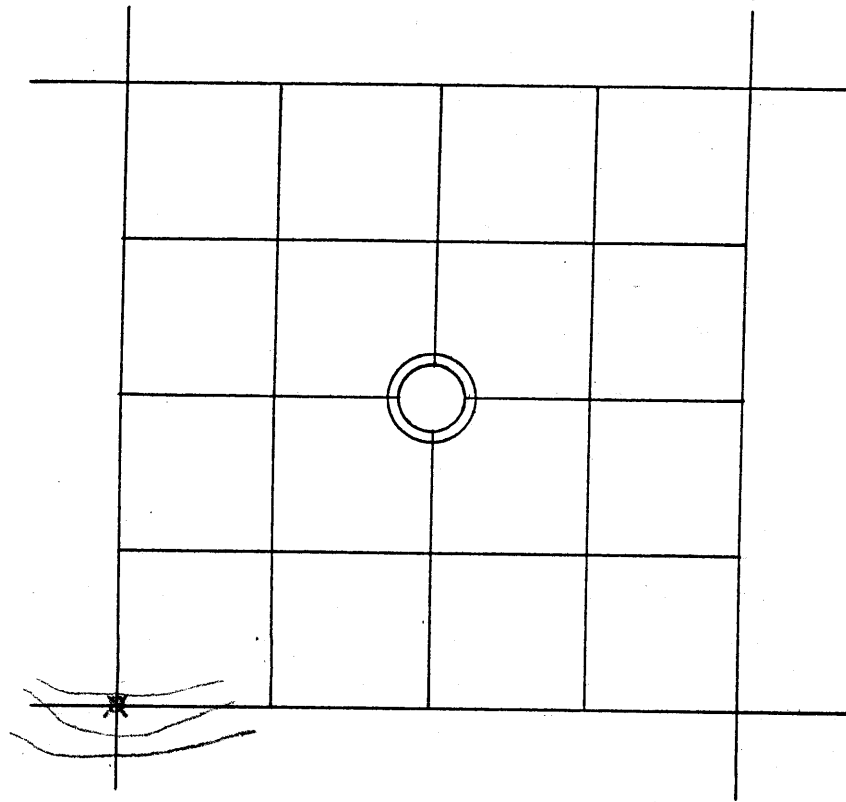

— // — // — // — LINE MARKED BY NOTCH CUT IN BLAZE.

○ — — — KNOWN CORNER.

⊗ — — — REFERENCED CORNER  
BY WEYERHAEUSER  
METHOD.

ACCESSORIES ADDED THIS DATE:

MAGNETIC DECLINATION 20°

	BEARING	FEET	ORIG. B.T.	"W" NAIL	PLATE	BRASS DISC
14" Hemlock	N11E	20.5	X	X	X	—
10" Chingua-pin	S86E	19.3	—	X	X	—
14" Chingua-pin	S38W	8.8	X	X	X	—
32" Fir	N74W	33.2	X	X	X	—

IDENTIFIED ON PHOTO:

INFORMATION ON LOCATION OF CORNER AS NOW SET:

GROUND COVER: Small opening - Rhododendron.

(USING FORM LINES SKETCH TOPOG AT CORNER ON PAGE 2 PLAT)

SLOPE FACES (GIVE BEARING IN DEGREES) S15E ON MINUS (-) 25 %

NORTH: +1970, old growth to East and West.

FROM CORNER -

SOUTH: -2770 " " " " "

EAST: Level 40', - 870, old growth to North and South.

WEST: Level 35', - 1990 " " " "

WORK DONE FOR W. T. CO.:

FIELD NOTES IN BOOK:

BY: Glen McChesney  
ENGINEER - SURVEYOR

DATE: July 30, 1958

UNDER THE SUPERVISION OF:

ASSISTED BY:

COPIES SENT TO:

SEAL