


# PUBLIC LAND CORNERS

WEYERHAEUSER TIMBER COMPANY  
 SPRINGFIELD BRANCH

TOWNSHIP 255 RANGE 2 W  
 SECTION 24 CORNER S 1/4  
 COUNTY Douglas OREGON

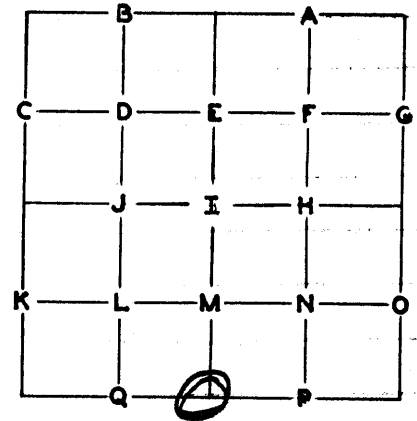

**GLO SURVEY RECORD**

CORNER Stone DATE: 1900

PRESENT CONDITION - (DESCRIBE FULLY - USE PAGE 2 IF NEEDED FOR EXPLANATION.)

*Found 1/4" N face. Stone moved by tree felled across it.*

**ACCESSORIES:**

	BEARING-	LINKS-	FEET-
<i>20" Cedar</i>	<i>N44E</i>	<i>10</i>	<i>6.6</i>
<i>18" Hemlock</i>	<i>S50W</i>	<i>4</i>	<i>2.6</i>

*Tree leaning slightly to North and face sloughed away.  
 22" Hem. Scribing visible*

SURVEY RECORD  
 DATE: \_\_\_\_\_

PRESENT CONDITION: \_\_\_\_\_


CORNER SET: *Original Stone set in place by* MAG. DECL: *20°*  
*distance from both BTs and by bearing from Hem. BT to SW.*

**BEARING AND DISTANCE TO ABOVE IDENTIFIED SURVEY ACCESSORIES:**

BEARING-	FEET-	SURVEY -	
<i>N41E</i>	<i>6.6</i>	<i>BLO</i>	<i>20" Cedar.</i>
<i>S50W</i>	<i>2.6</i>	<i>"</i>	<i>22" Hem.</i>


CS 53/112-34

SECTION 24 TOWNSHIP 25S RANGE 2W

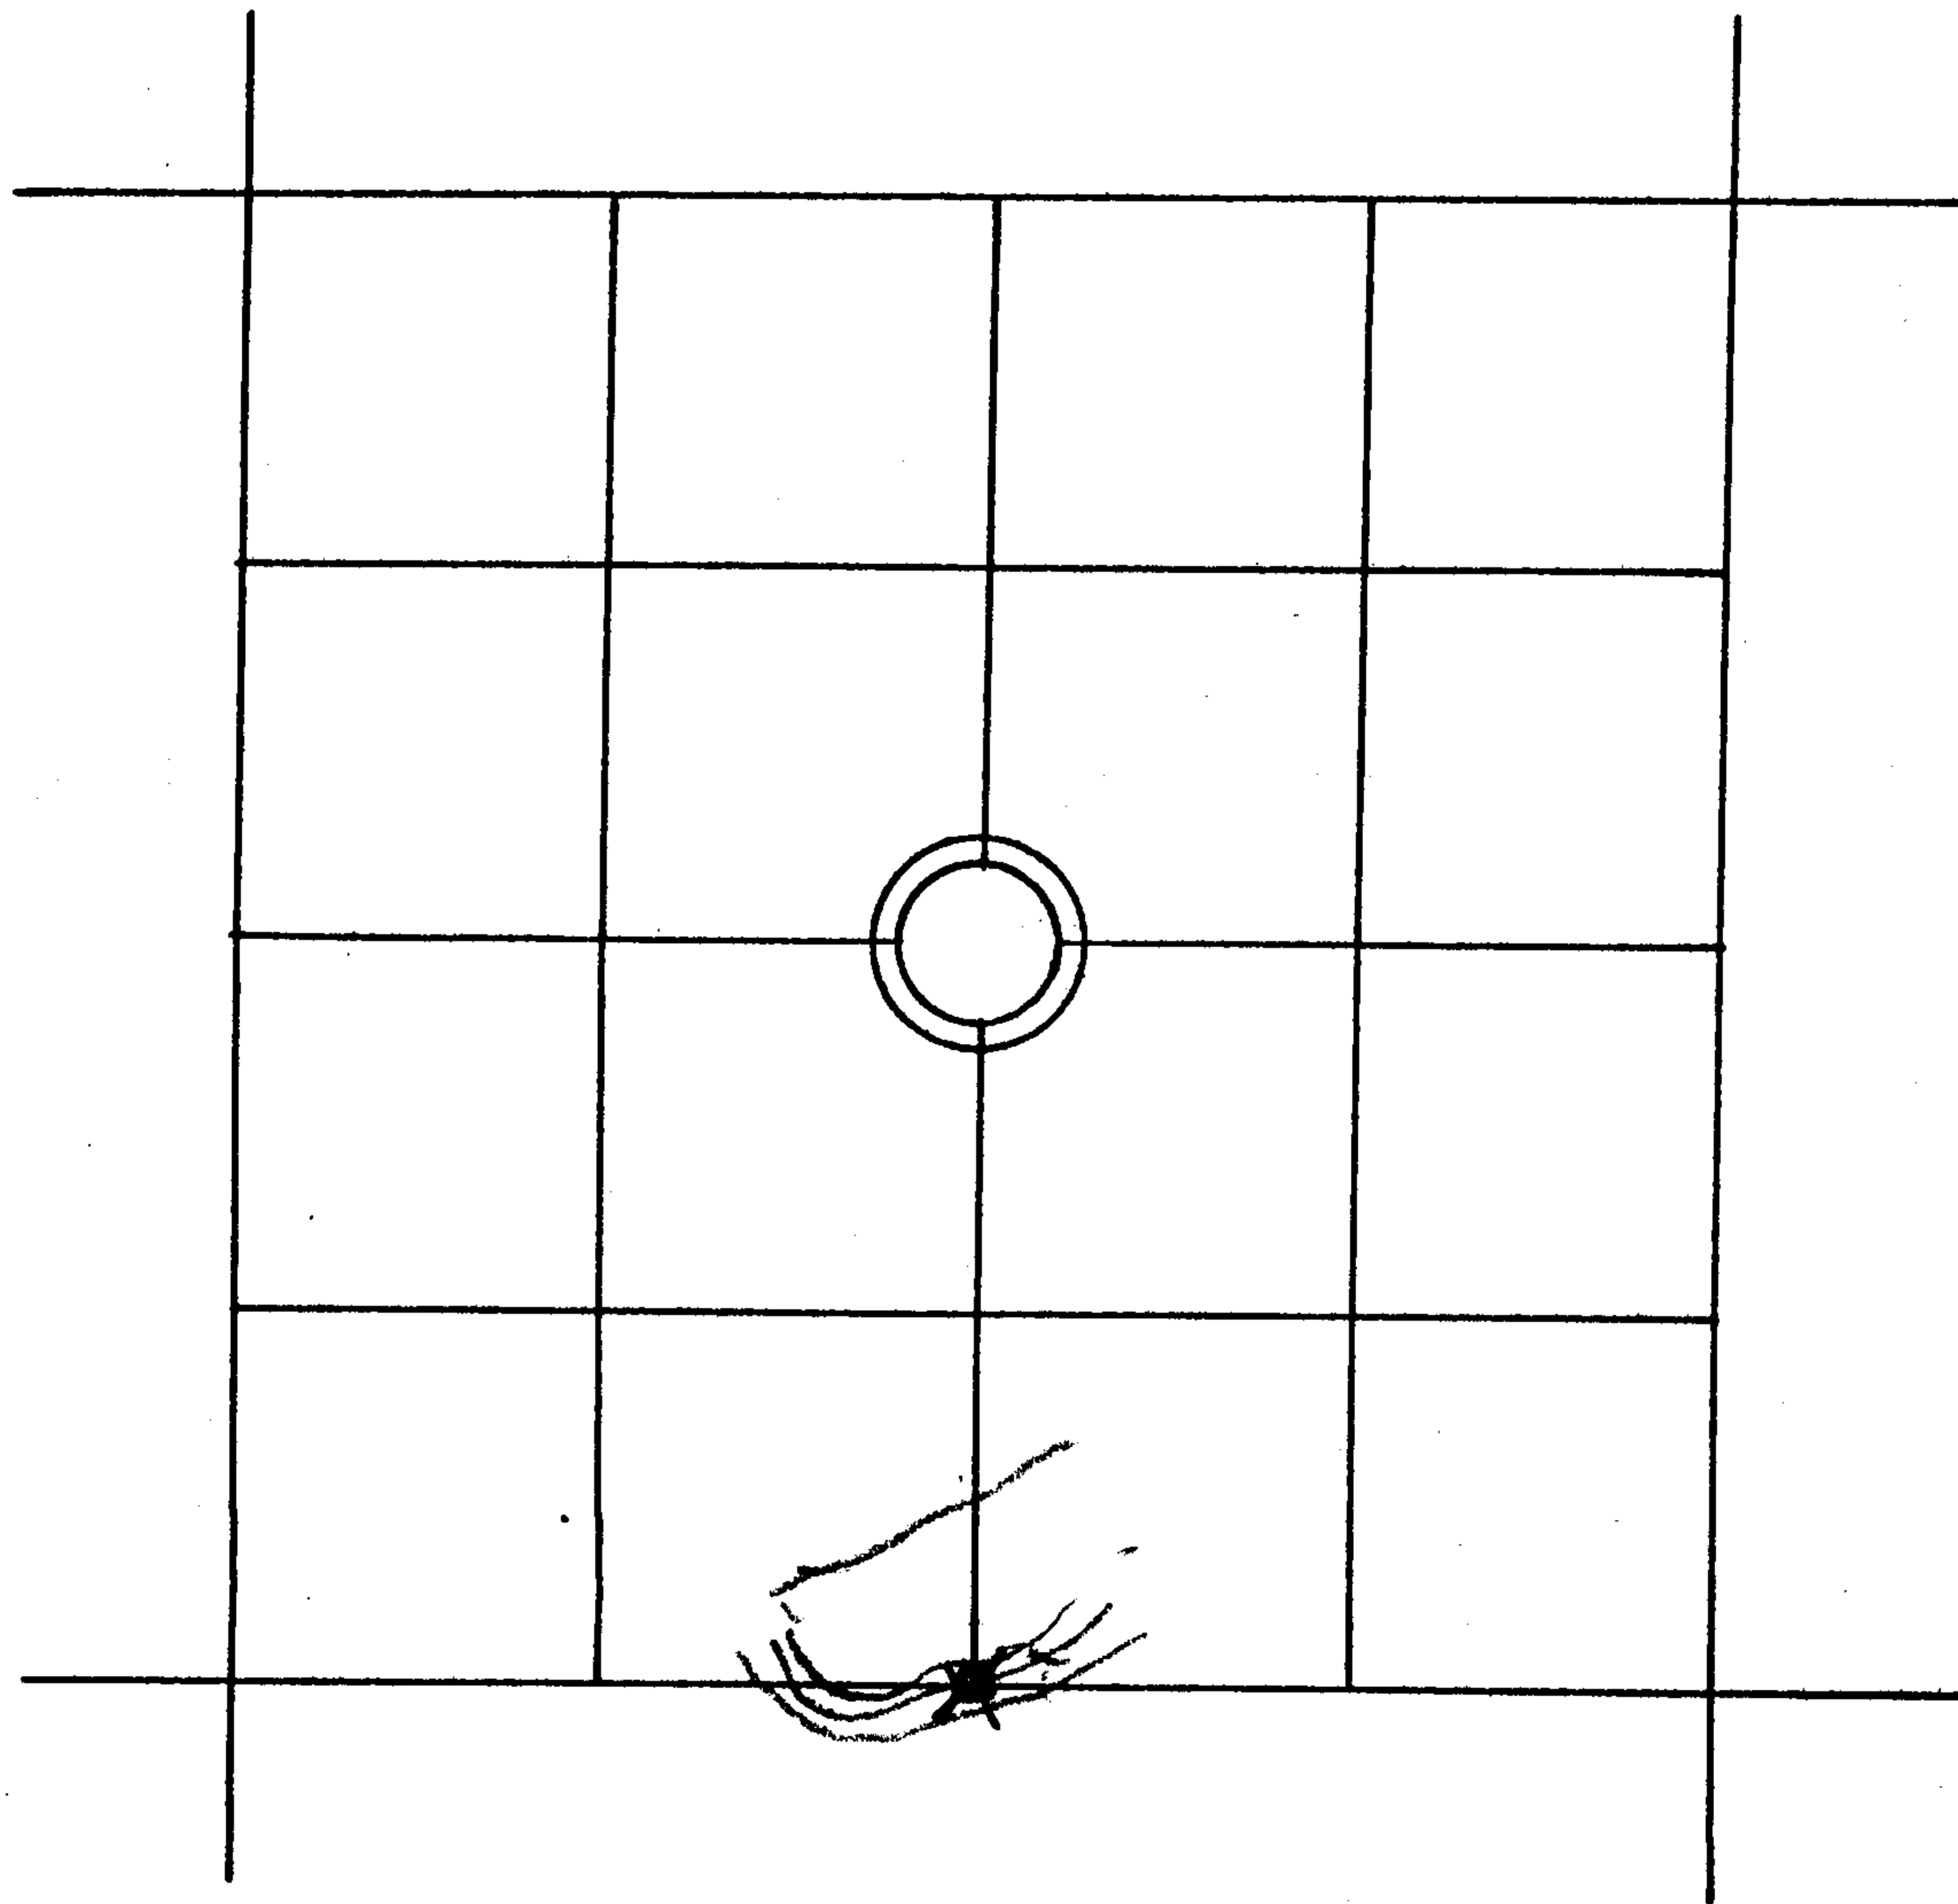

 LINE MARKED BY NOTCH CUT IN BLAZE.

 --- KNOWN CORNER.

 --- REFERENCED CORNER  
BY WEYERHAEUSER  
METHOD.

ACCESSORIES ADDED THIS DATE:

MAGNETIC DECLINATION

20

	BEARING	FEET	ORIG. B.T.	"W" NAIL	PLATE	BRASS DISC
20" Cedar	N41E	6.6	X	X	X	—
22" Hemlock	S57W	2.4	X	X	X	—

IDENTIFIED ON PHOTO:

INFORMATION ON LOCATION OF CORNER AS NOW SET:

GROUND COVER: Rhododendron

(USING FORM LINES SKETCH TOPOG AT CORNER ON PAGE 2 PLAT)

SLOPE FACES (GIVE BEARING IN DEGREES) North ON MINUS (-) 46 %

NORTH: -46% 60' then level; through old growth.

FROM CORNER -

SOUTH: +33% 120' to new logging road; through R/W cutting.

EAST: +4% R/W cutting to south, old growth to north.

WEST: -10% Cutting to south, old growth to north.

WORK DONE FOR W. T. CO.:

FIELD NOTES IN BOOK:

BY: Glen Mc Chesney DATE: July 30, 1958  
ENGINEER - SURVEYOR

UNDER THE SUPERVISION OF:

ASSISTED BY:

COPIES SENT TO:

SEAL