


PUBLIC LAND CORNERS

WEYERHAEUSER TIMBER COMPANY
 SPRINGFIELD BRANCH

TOWNSHIP 25 S RANGE 2 W
 SECTION 24 CORNER L 1/16
 COUNTY Douglas OREGON

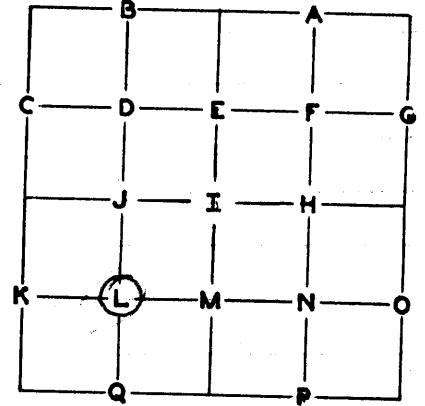

GLO SURVEY RECORD

CORNER _____ DATE: _____

PRESENT CONDITION - (DESCRIBE FULLY -
 USE PAGE 2 IF NEEDED FOR EXPLANATION.)

ACCESSORIES:

BEARING-	LINKS-	FEET-

Hosford SURVEY RECORD
 DATE: 1957
 Corner: 20" Cedar Tree.
20" Hem. N76E 22.4
12" Hem S53W 35.5

PRESENT CONDITION: _____
Found Scribed on four Sides
Found Scribed
Found Scribed


CORNER SET: 20" Cedar Tree - Hosford Survey MAG. DECL: 20°

BEARING AND DISTANCE TO ABOVE IDENTIFIED SURVEY ACCESSORIES:

BEARING-	FEET-	SURVEY -
<u>N76E</u>	<u>22.4</u>	<u>Hosford 20" Hemlock</u>
<u>S53W</u>	<u>35.5</u>	<u>)) 12" Hemlock</u>


CS 53/112-36

SECTION 24 TOWNSHIP 25S RANGE 2W

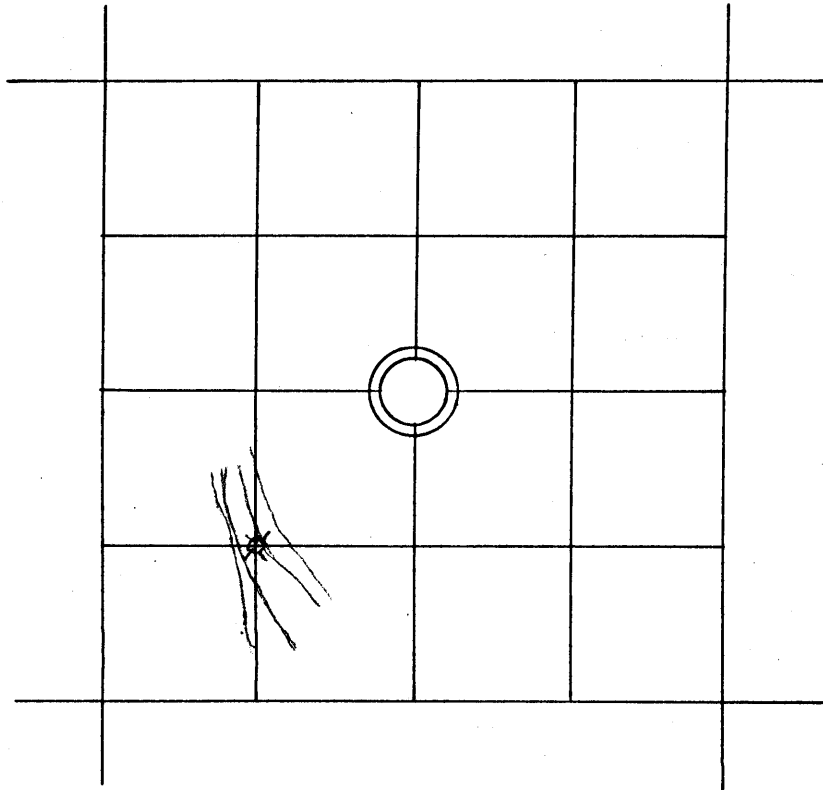

 LINE MARKED BY NOTCH CUT IN BLAZE.

 --- KNOWN CORNER.

 --- REFERENCED CORNER
BY WEYERHAEUSER
METHOD.

ACCESSORIES ADDED THIS DATE:

MAGNETIC DECLINATION 20°

	BEARING	FEET	ORIG. D.F.	"W" NAIL	PLATE	BRASS DISC
20" Hem	N76E	22.1	Hasford	X	X	
40" Fir	S24E	22.0		X	X	

IDENTIFIED ON PHOTO:

INFORMATION ON LOCATION OF CORNER AS NOW SET:

GROUND COVER: Rhododendron, Oregon Grape

(USING FORM LINES SKETCH TOPOG AT CORNER ON PAGE 2 PLAT)

SLOPE FACES (GIVE BEARING IN DEGREES) West ON MINUS (-) 28 %

NORTH: +10% Through Old Growth.

FROM CORNER | SOUTH: -10%. Logged to West, old growth to East

EAST: +20% through old growth.

WEST: -28%. Logged to South, old growth to North. Approx. 990' to dirt road.

WORK DONE FOR W. T. CO.:

FIELD NOTES IN BOOK: _____

BY: Allen McChesney
ENGINEER - SURVEYOR

DATE: 5/20/58

UNDER THE SUPERVISION OF:

ASSISTED BY: _____

COPIES SENT TO: _____

SEAL

COUNTY SURVEYOR
DOUGLAS COUNTY, ORE.

AUG 20 1958

FILED
RECEIVED

36	31	32	33	34	35	36	31
1	6	5	4	3	2	1	6
12	7	8	9	10	11	12	7
13	18	17	16	15	14	13	18
24	19	20	21	22	23	24	19
25	30	29	28	27	26	25	30
36	31	32	33	34	35	36	31
1	6	5	4	3	2	1	6

WEYERHAEUSER TIMBER COMPANY

CORNER REFERENCE METHOD CONSISTS OF:

A "W" NAIL DRIVEN THRU THE HOLE IN A BRASS DISC, INTO A NOTCH CUT LOW ON A TREE, STAMPED WITH THE OREGON REGISTERED LAND SURVEYOR OR PROFESSIONAL ENGINEER REGISTRATION NUMBER.

AN EMBOSSED ALUMINUM PLATE, NAILED HEAD HIGH ON SAME TREE WITH 8D ALUMINUM NAILS, WITH DISTANCE AND BEARING FROM THE W NAIL TO THE CORNER STAMPED ON IT.

