


# PUBLIC LAND CORNERS

WEYERHAEUSER TIMBER COMPANY  
 SPRINGFIELD BRANCH

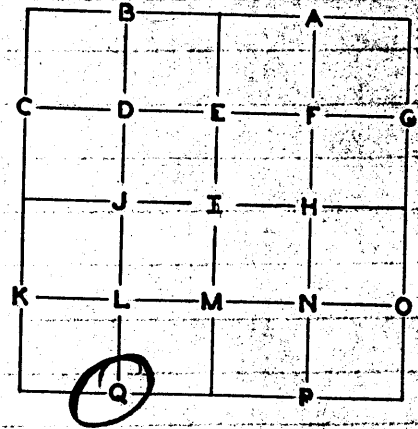

TOWNSHIP 25S RANGE 2W  
 SECTION 24 CORNER Q = W 1/16  
 COUNTY Douglas OREGON

**GLO SURVEY RECORD**

DATE: \_\_\_\_\_

CORNER \_\_\_\_\_

**ACCESSORIES:**

BEARING-	LINKS-	FEET-

**PRESENT CONDITION - (DESCRIBE FULLY - USE PAGE 2 IF NEEDED FOR EXPLANATION.)**

**Vern Hasford SURVEY RECORD**

DATE: 1955

4" Hem post

24" Cedar - N88 1/2 E - 37.3'

24" Cedar - S4E - 18.6'

**PRESENT CONDITION:**

Destroyed by building "cat" fire trail.

24" Cedar. Hasford's scribing visible.

24" Cedar. " " "


CORNER SET: 3" square yew post set by distance. MAG. DECL: 20°

**BEARING AND DISTANCE TO ABOVE IDENTIFIED SURVEY ACCESSORIES:**

BEARING-	FEET-	SURVEY -	
<u>N87 1/2 E</u>	<u>37.3</u>	<u>Hasford</u>	<u>24" Cedar.</u>
<u>S5E</u>	<u>18.6</u>	<u>"</u>	<u>24" Cedar.</u>

CS 53/112-37

SECTION 24 TOWNSHIP 25S RANGE 2W

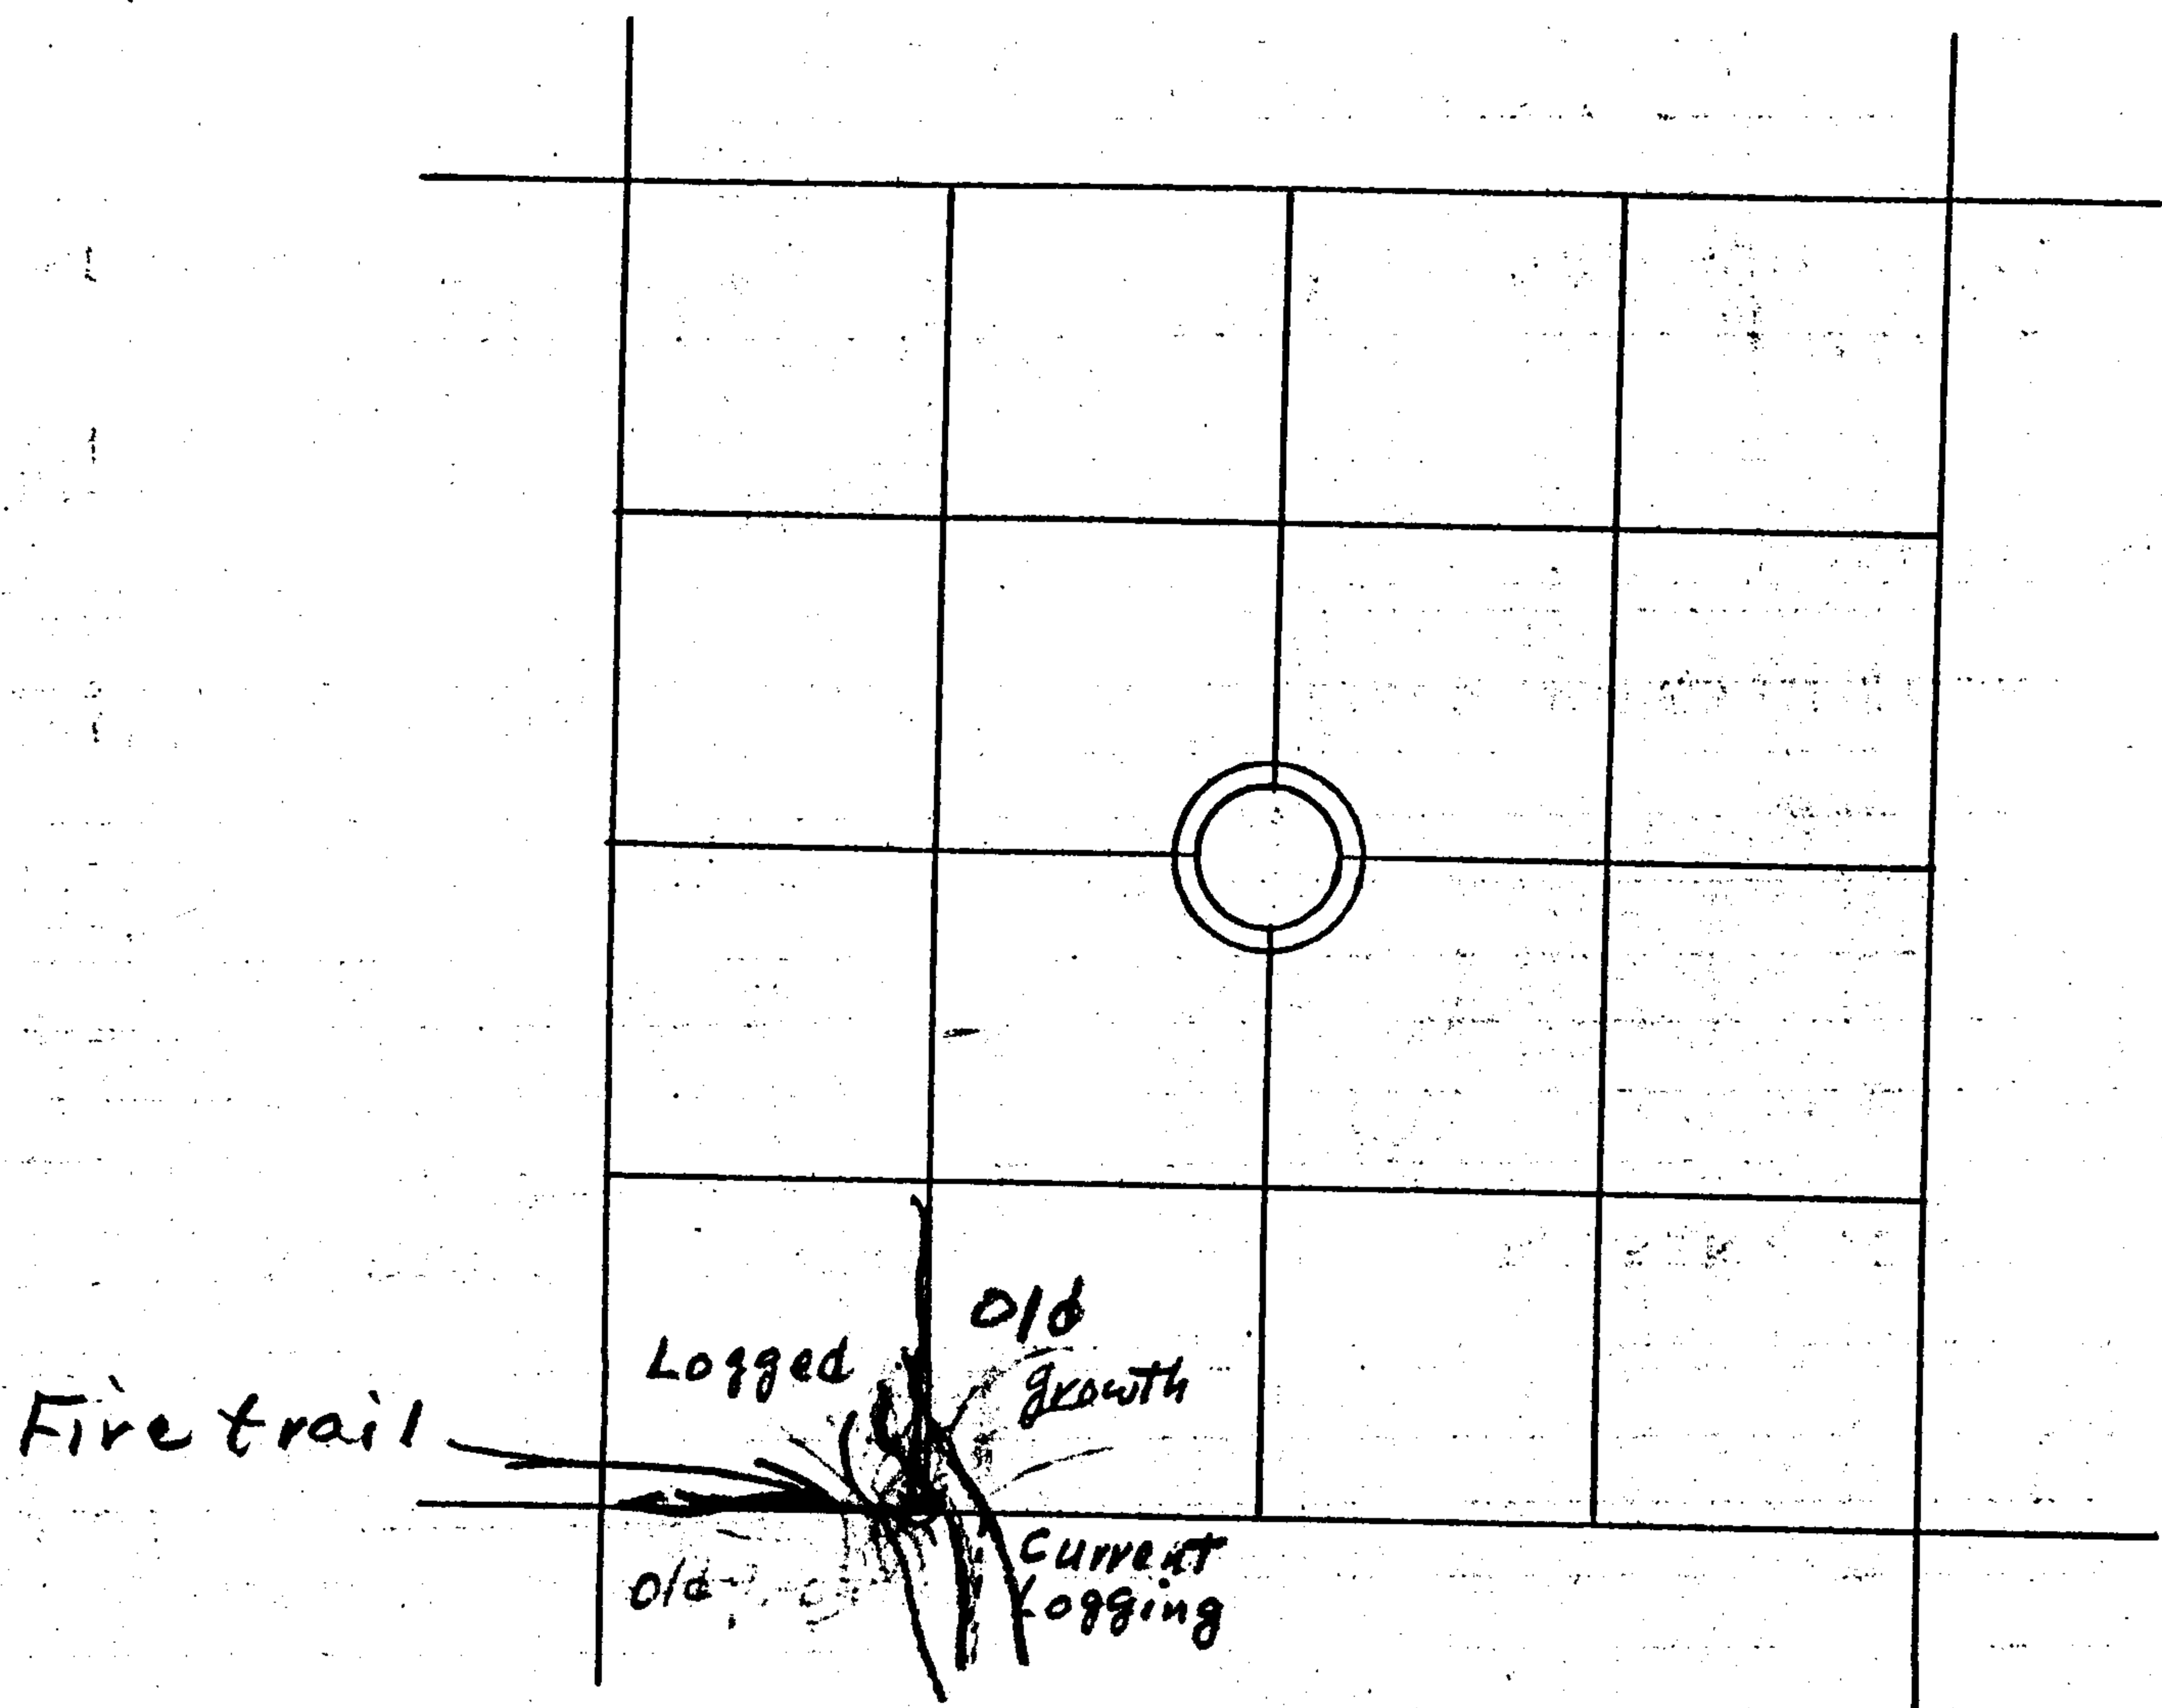

—||—||—||— LINE MARKED BY NOTCH CUT IN BLAZE.

○...KNOWN CORNER.

⊗...REFERENCED CORNER BY WEYERHAEUSER METHOD.

ACCESSORIES ADDED THIS DATE:

MAGNETIC DECLINATION 20

	BEARING	FEET	ORIG. B.T.	'W' NAIL	PLATE	BRASS DISC
40" Fir	N 21 E	22.2		X	X	—
24" Cedar	S 5 E	18.2	Hosford	X	X	—

IDENTIFIED ON PHOTO:

INFORMATION ON LOCATION OF CORNER AS NOW SET:

GROUND COVER: Corner falls on South edge of "Cat" fire trail.

(USING FORM LINES SKETCH TOPOG AT CORNER ON PAGE 2 PLAT)

SLOPE FACES (GIVE BEARING IN DEGREES) S 45 W ON MINUS (-) 2 1 %

FROM CORNER -

NORTH: Level 12' across cat trail then + 69° 80' old growth to East, logged and burned to West.

SOUTH: - 129° through Virgin Stand.

EAST: + 119°. old growth to North and to South for 330' where cutting starts.

WEST: - 189°. logged to N, old growth to South.

WORK DONE FOR W. T. CO.:

FIELD NOTES IN BOOK:

BY: Glen Mc Chesney  
ENGINEER - SURVEYOR

DATE: July 30, 1958

UNDER THE SUPERVISION OF:

*believe 1958 since other documents by Mc Chesney also dated July 30, 1958*  
N. Winchell  
SURVEYOR OFFICE

ASSISTED BY:

COPIES SENT TO:

SEAL