


# PUBLIC LAND CORNERS

WEYERHAEUSER TIMBER COMPANY  
 SPRINGFIELD BRANCH

TOWNSHIP 25S RANGE 2W

SECTION 24 CORNER Q = W 1/16

COUNTY Douglas OREGON

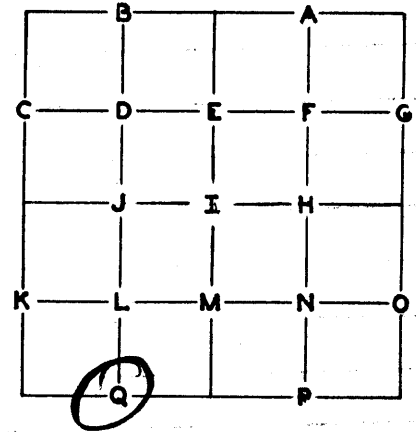

## GLO SURVEY RECORD

DATE: \_\_\_\_\_

CORNER \_\_\_\_\_

PRESENT CONDITION - (DESCRIBE FULLY -  
 USE PAGE 2 IF NEEDED FOR EXPLANATION.)

### ACCESSORIES:

BEARING-	LINKS-	FEET-

## Vern Hosford SURVEY RECORD

DATE: 1955

4" Hem post

24" Cedar - N88 1/2 E - 37.3'

24" Cedar - S4 E - 18.6'

PRESENT CONDITION: \_\_\_\_\_

Destroyed by building "cat" fire trail.

24" Cedar. Hosford's scribing visible.

24" Cedar. " " "


CORNER SET: 3" square yew post set by distance. MAG. DECL: 20°

### BEARING AND DISTANCE TO ABOVE IDENTIFIED SURVEY ACCESSORIES:

BEARING-	FEET-	SURVEY -
<u>N87 1/2 E</u>	<u>37.3</u>	<u>Hosford 24" Cedar.</u>
<u>S5 E</u>	<u>18.6</u>	<u>" 24" Cedar.</u>

CS 53/112-38

SECTION 24 TOWNSHIP 25S RANGE 2W

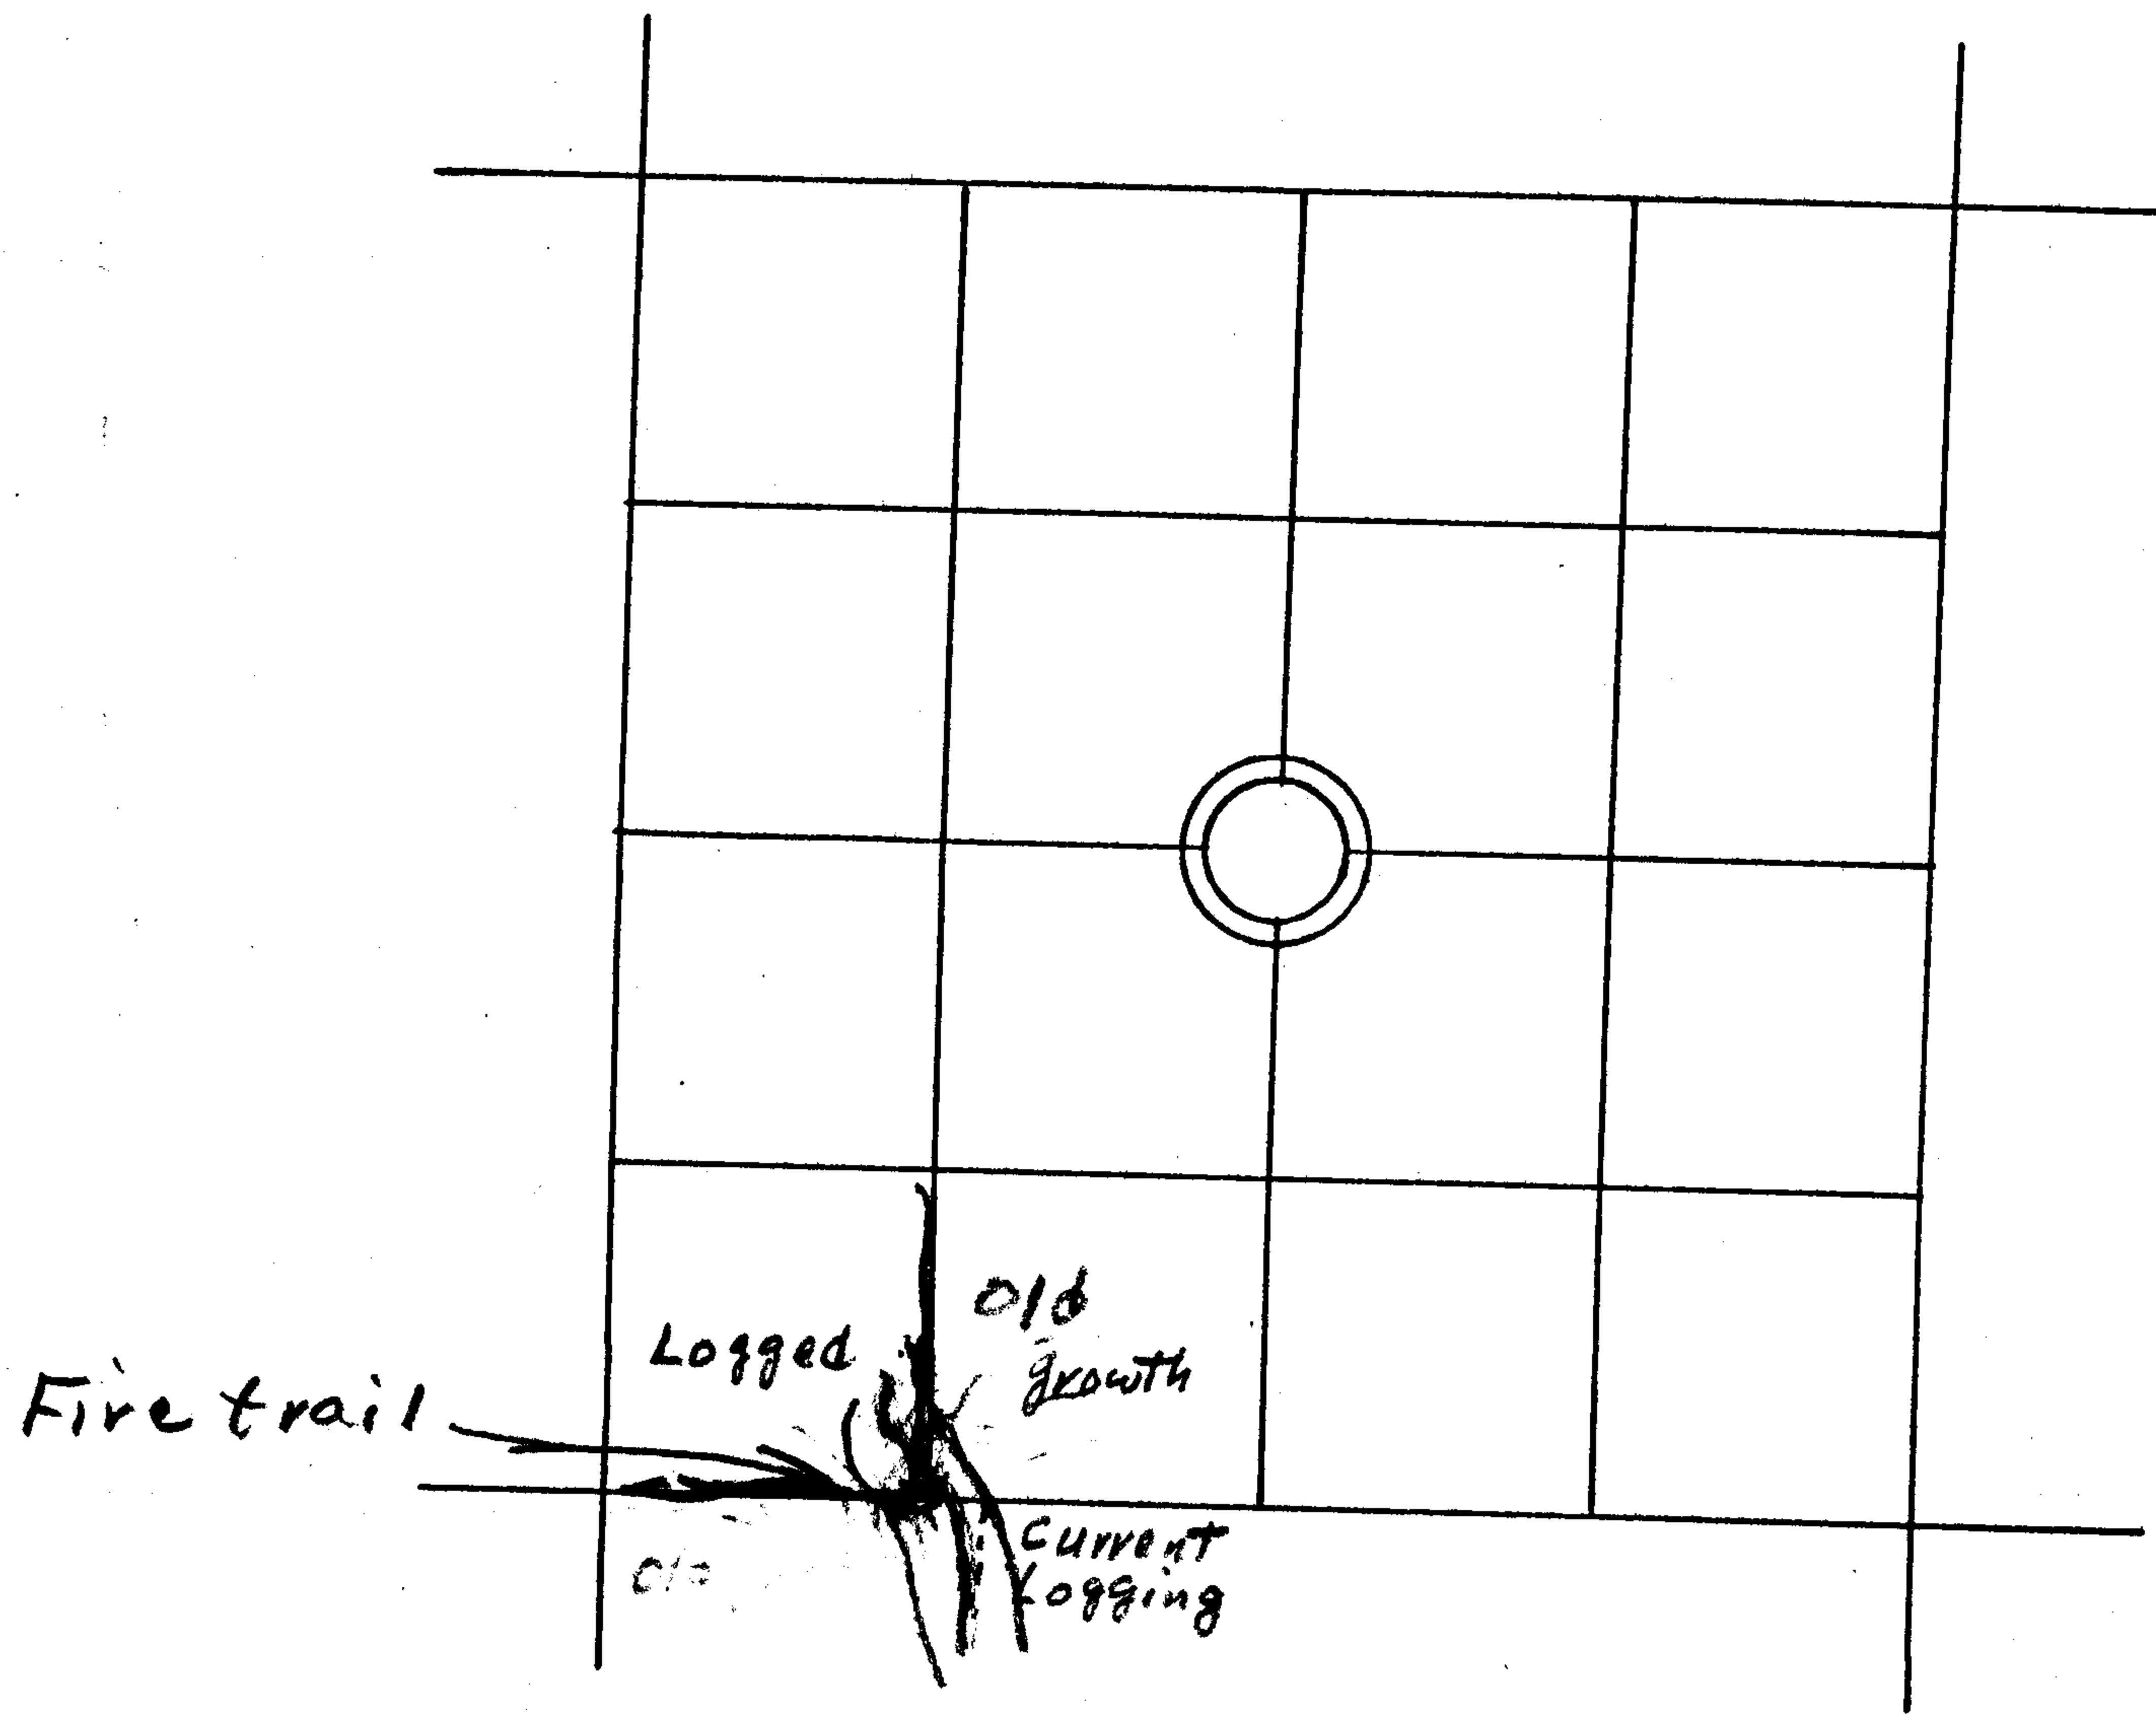

— — — LINE MARKED BY NOTCH CUT IN BLAZE.

○ — — — KNOWN CORNER.

⊗ — — — REFERENCED CORNER BY WEYERHAEUSER METHOD.

ACCESSORIES ADDED THIS DATE:

MAGNETIC DECLINATION 20

	BEARING	FEET	ORIG. B.T.	"W" NAIL	PLATE	BRASS DISC
40" Fir	N21E	22.2	—	X	X	—
24" Cedar	S5E	18.2	Hosford	X	X	—

IDENTIFIED ON PHOTO:

INFORMATION ON LOCATION OF CORNER AS NOW SET:

GROUND COVER: Corner falls on South edge of "cat" fire trail.

(USING FORM LINES SKETCH TOPOG AT CORNER ON PAGE 2 PLAT)

SLOPE FACES (GIVE BEARING IN DEGREES) S45W ON MINUS (-) 21 %

FROM CORNER -

NORTH: Level 12' across cat trail then + 670 80' old growth to East, logged and burned to West.

SOUTH: -1270 through Virgin Stand.

EAST: + 1170. old growth to North and to South for 330' where cutting starts.

WEST: -1870. logged to N, old growth to South.

WORK DONE FOR W. T. CO.:

FIELD NOTES IN BOOK:

BY: Glen Mc Chesney  
ENGINEER - SURVEYOR

DATE: July 30, 19

UNDER THE SUPERVISION OF:

believe 1958 since other documents by me Chesney also dated July 30, 1958  
N. Winchell  
SURVEYOR OFFICE

ASSISTED BY:

COPIES SENT TO:

SEAL