


PUBLIC LAND CORNERS

WEYERHAEUSER TIMBER COMPANY
 SPRINGFIELD BRANCH

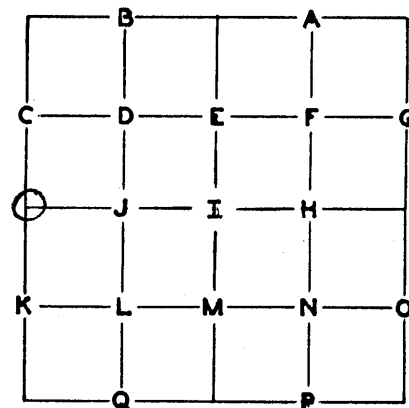

TOWNSHIP 25S RANGE 2W

SECTION 24 CORNER W 1/4

COUNTY Douglas OREGON

GLO SURVEY RECORD

DATE: 1900
 CORNER Stone

PRESENT CONDITION - (DESCRIBE FULLY -
 USE PAGE 2 IF NEEDED FOR EXPLANATION.)

Found. "1/4" North face.

ACCESSORIES:

	BEARING-	LINKS-	FEET-	
<u>65" Fir</u>	<u>N69E</u>	<u>14</u>	<u>9.2</u>	<u>72" Fir, large, low face.</u>
<u>30" Fir</u>	<u>N32W</u>	<u>24</u>	<u>15.8</u>	<u>Stamp Shell. Scribing Visible. Burned and Rotted.</u>

Hosford SURVEY RECORD
 DATE: 1957

Iron Pipe

7" Hem. N78W 66.0'

PRESENT CONDITION: _____

Beside original Stone.

Found Scribed by Hosford.

CORNER SET: Original Stone


MAG. DECL: 20°

BEARING AND DISTANCE TO ABOVE IDENTIFIED SURVEY ACCESSORIES:

BEARING-	FEET-	SURVEY-	
<u>N69E</u>	<u>9.2</u>	<u>GLO</u>	<u>72" Fir</u>
<u>N32W</u>	<u>16</u>	<u>GLO</u>	<u>Stamp Shell.</u>
<u>N78W</u>	<u>66</u>	<u>Hosford</u>	<u>Hosford BT-Hem.</u>

CS 53/112-39

SECTION 24 TOWNSHIP 255 RANGE 2W

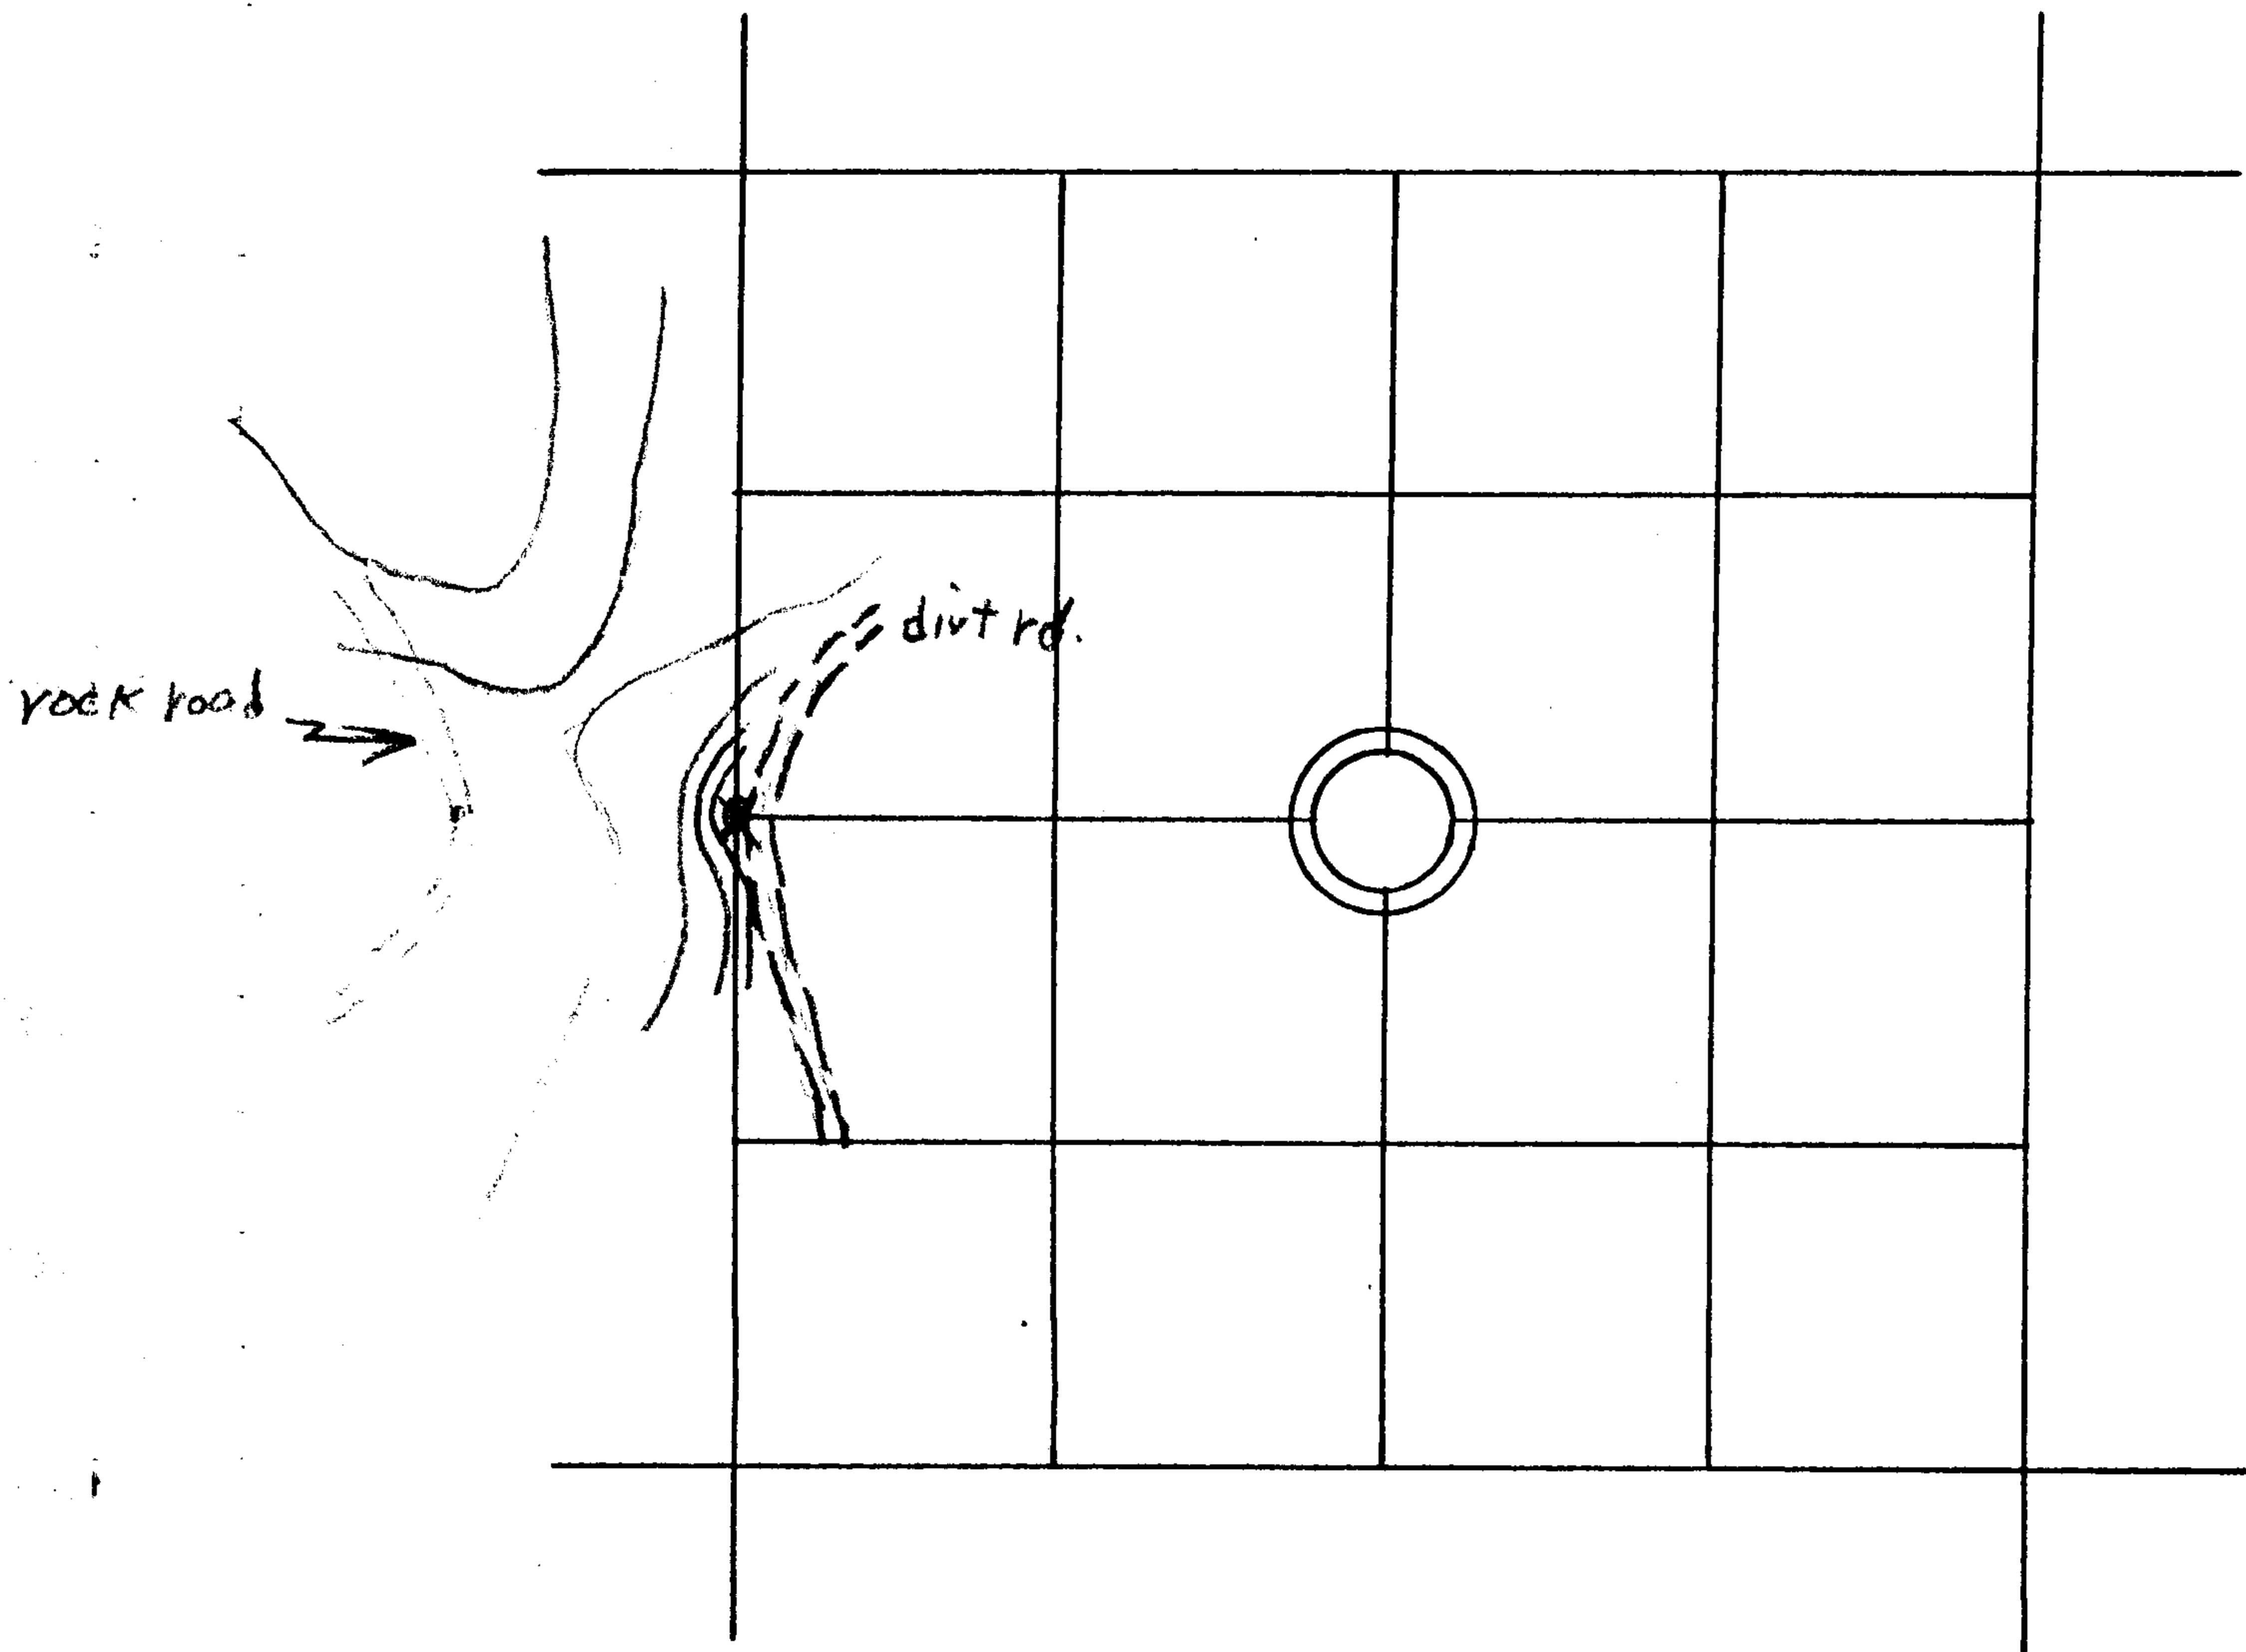

—//—//—//— LINE MARKED BY NOTCH CUT IN BLAZE.

○...KNOWN CORNER.

⊗...REFERENCED CORNER BY WEYERHAEUSER METHOD.

ACCESSORIES ADDED THIS DATE:

MAGNETIC DECLINATION

20°

	BEARING	FEET	ORIG. B.T.	"W" NAIL	PLATE	BRASS DISC
72" Fir	N61E	9.3	X	X	X	
50" Fir	S40W	31.0		X	X	

IDENTIFIED ON PHOTO:

INFORMATION ON LOCATION OF CORNER AS NOW SET:

GROUND COVER: Logging slash

(USING FORM LINES SKETCH TOPOG AT CORNER ON PAGE 2 PLAT)

SLOPE FACES (GIVE BEARING IN DEGREES) West ON MINUS (-) 25 %

NORTH: +3 70 Along West side dirt road.

FROM CORNER - SOUTH: +20 90 20' then level. Old growth to East, logged to West.

EAST: +50 90 25' to dirt road.

WEST: -25 90 70', -12 90. 290' to W.T. Co plate on East Side Rock Road.

WORK DONE FOR W. T. CO.:

FIELD NOTES IN BOOK:

BY: Glen McCreaney ENGINEER - SURVEYOR

DATE: 5/20/58

UNDER THE SUPERVISION OF:

ASSISTED BY:

COPIES SENT TO:

SEAL