


PUBLIC LAND CORNERS

WEYERHAEUSER TIMBER COMPANY
SPRINGFIELD BRANCH

TOWNSHIP 25S RANGE 2W
SECTION 26 CORNER N 1/4
COUNTY Douglas OREGON

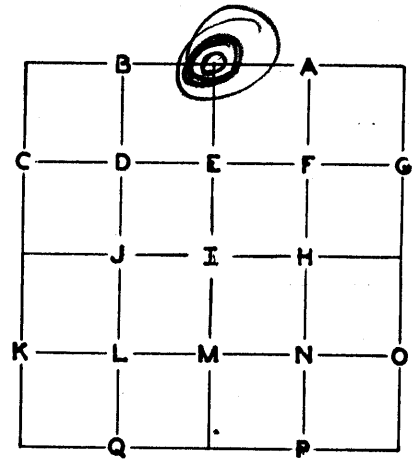

GLO SURVEY RECORD

DATE: 1900
CORNER Stone - 1/4 N Face

PRESENT CONDITION - (DESCRIBE FULLY - USE PAGE 2 IF NEEDED FOR EXPLANATION.)

Found Stone

ACCESSORIES:

BEARING-	LINKS-	FEET-	
<u>12" Hem.</u>	<u>N53E</u>	<u>53</u>	<u>35.0</u>
<u>22" Hem.</u>			<u>Face once chopped out, grown over.</u>
<u>9" Hem</u>	<u>S25E</u>	<u>31</u>	<u>20.5</u>
			<u>12" Hem. Scribing visible. Scarred by logging</u>

SURVEY RECORD
DATE: _____

PRESENT CONDITION: _____

CORNER SET: Stone set 1900 GLO Survey MAG. DECL: 20°


Planted 3" square vine maple post beside Stone

BEARING AND DISTANCE TO ABOVE IDENTIFIED SURVEY ACCESSORIES:

BEARING-	FEET-	SURVEY-	
<u>N56E</u>	<u>35.0</u>	<u>GLO</u>	<u>22" Hem.</u>
<u>S26E</u>	<u>20.2</u>	<u>GLO</u>	<u>12" scribed Hem.</u>

CS 53/112-40

SECTION 26 TOWNSHIP 25S RANGE 2W

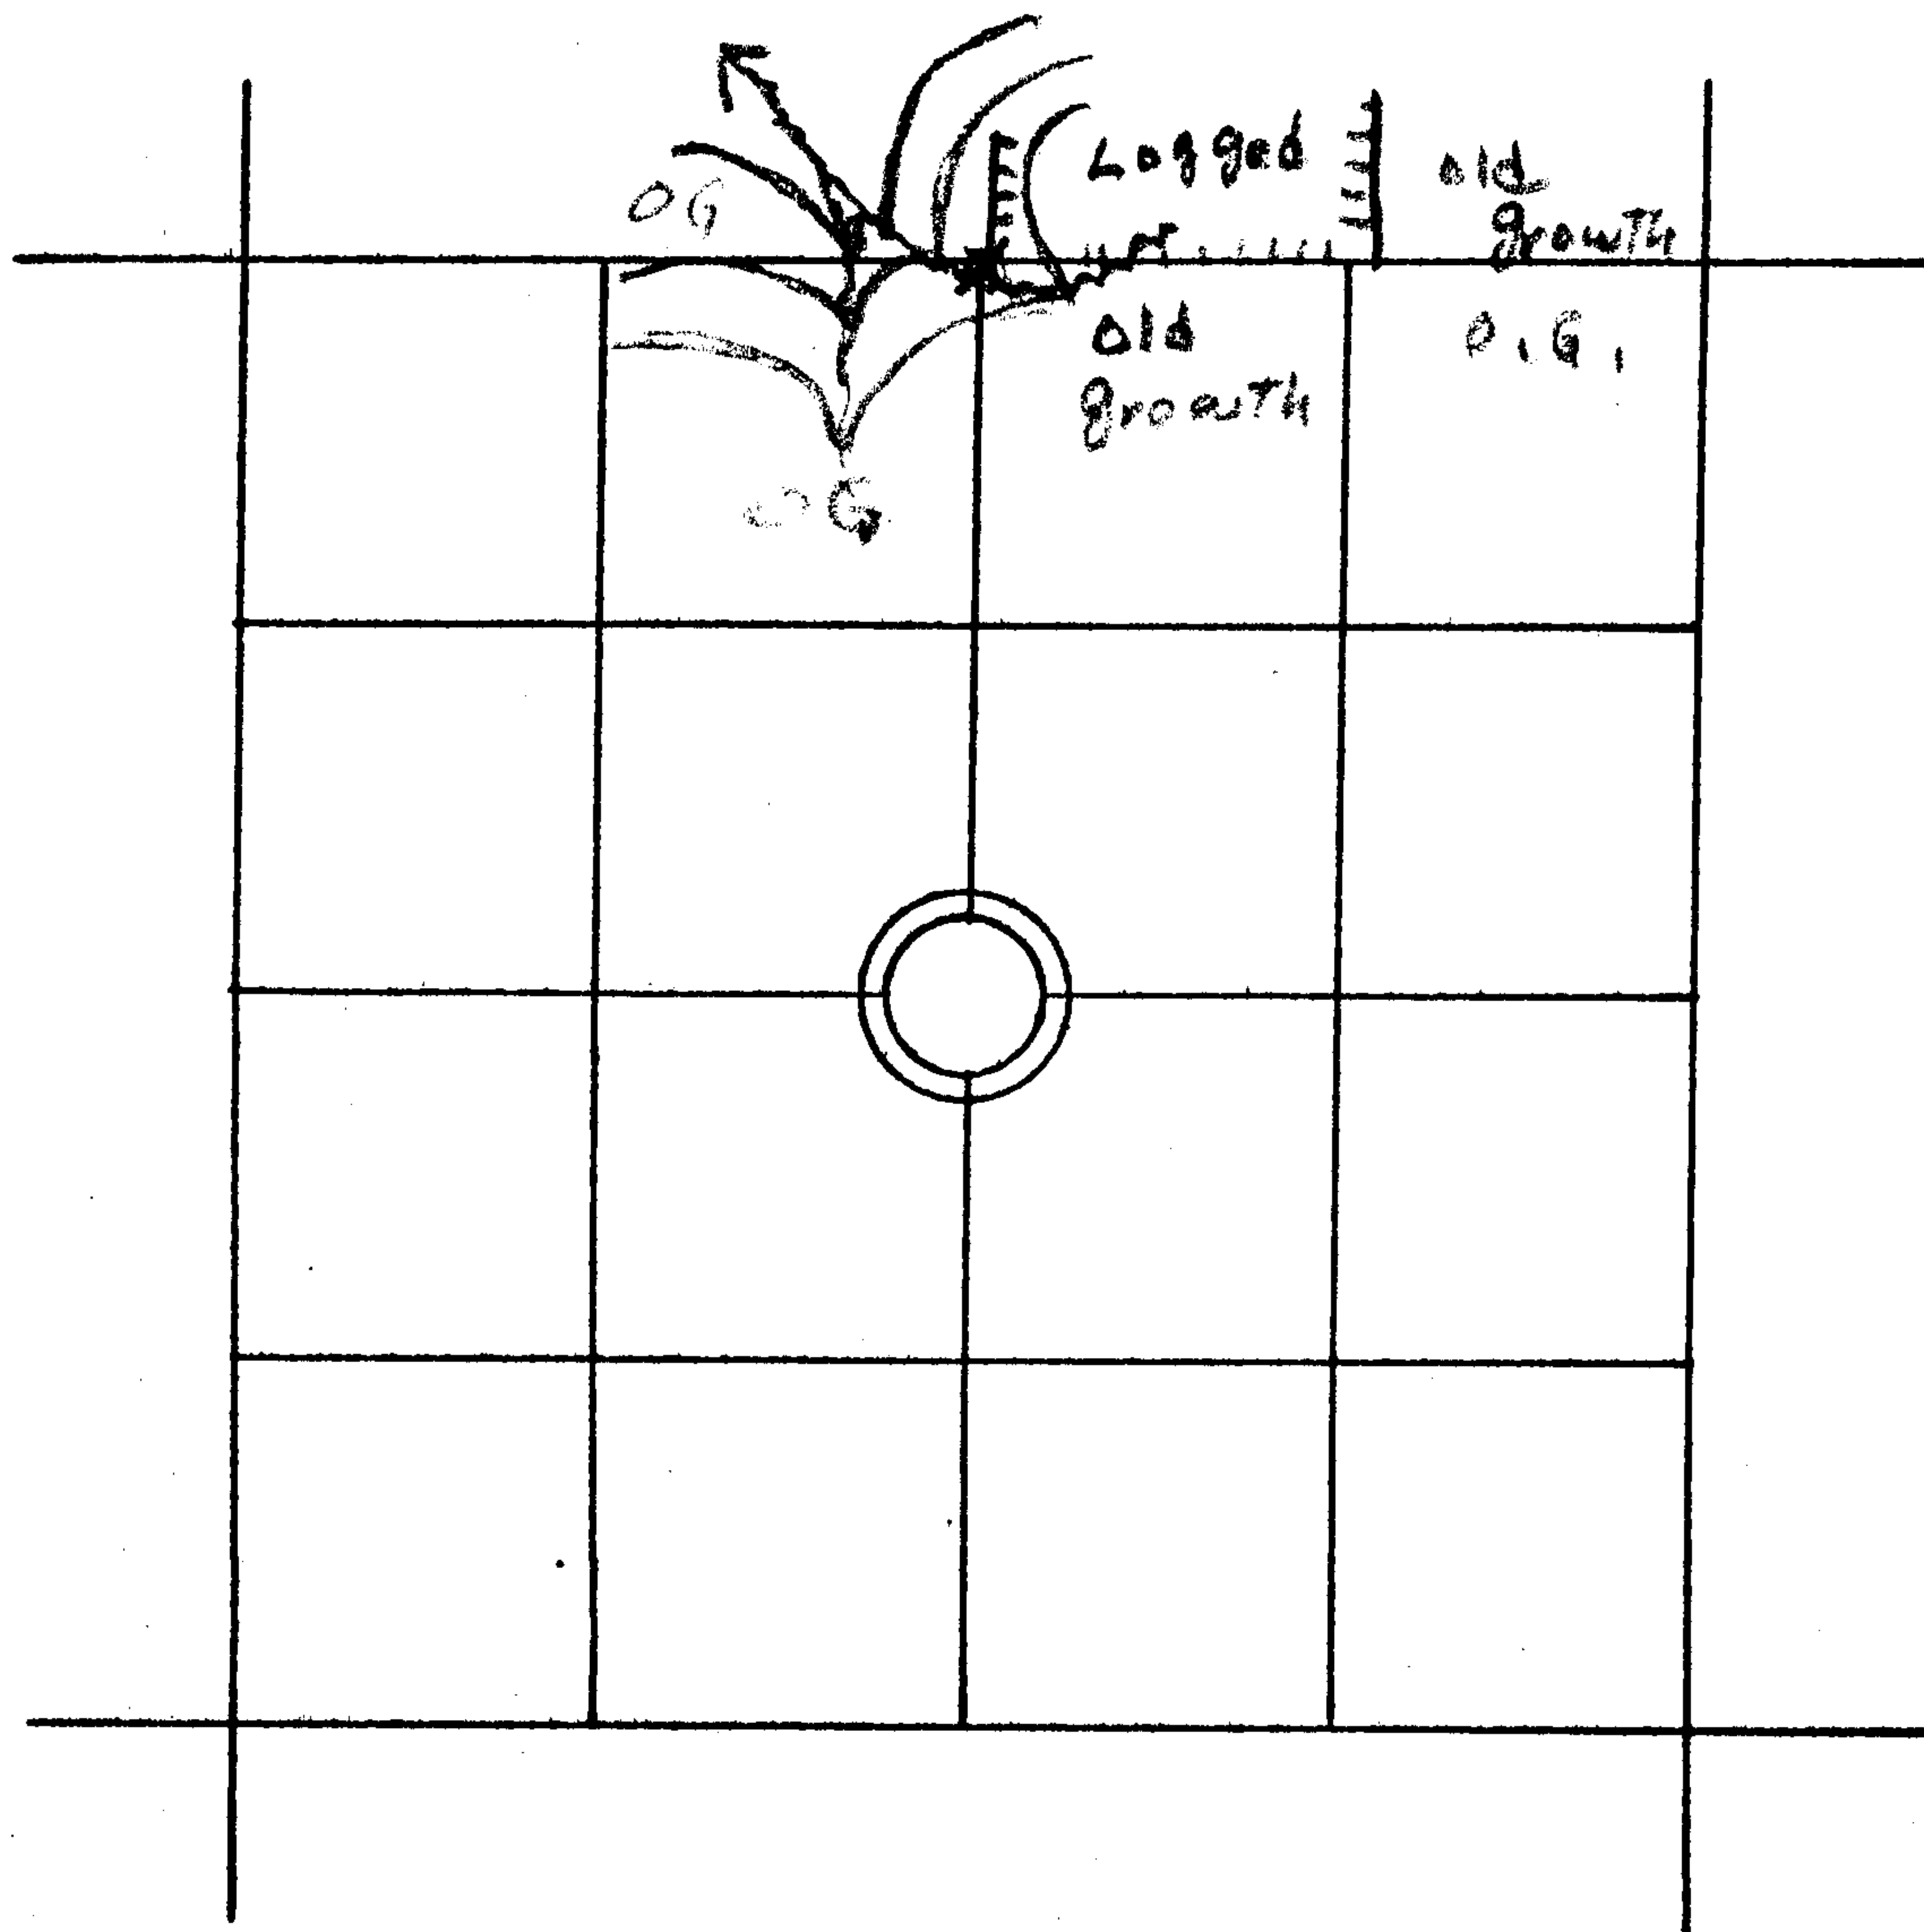

—||—||—||— LINE MARKED BY NOTCH CUT IN BLAZE.

○...KNOWN CORNER.

⊗...REFERENCED CORNER
BY WEYERHAEUSER
METHOD.

ACCESSORIES ADDED THIS DATE:

MAGNETIC DECLINATION 20°

	BEARING	FEET	ORIG. B.T.	"W" NAIL	PLATE	BRASS DISC
50" Fir	N67E	13.1	—	X	X	
12" Hem.	S27E	20.2	X	X	X	

IDENTIFIED ON PHOTO: No

INFORMATION ON LOCATION OF CORNER AS NOW SET:

GROUND COVER: Vine maple, at SW edge of 1957-58 logging
(USING FORM LINES SKETCH TOPOG AT CORNER ON PAGE 2 PLAT)

SLOPE FACES (GIVE BEARING IN DEGREES) S45W ON MINUS (-) 20 %

NORTH: +25% 50', logged to East, old growth to West

SOUTH: -25% 6' to Creek C-N65W

EAST: +23% . Logged to North, old growth to South,

WEST: -20% 15' to Creek Course NW, then over low spur ridge 80' to Creek Course North.

WORK DONE FOR W. T. CO.:

FIELD NOTES IN BOOK: _____

BY: Glen McChesney DATE: 8/11/58
ENGINEER - SURVEYOR

UNDER THE SUPERVISION OF:

ASSISTED BY: _____

COPIES SENT TO: _____

SEAL