


PUBLIC LAND CORNERS

WEYERHAEUSER TIMBER COMPANY
SPRINGFIELD BRANCH

TOWNSHIP 25S RANGE 2W
SECTION 26 CORNER NE
COUNTY Douglas OREGON

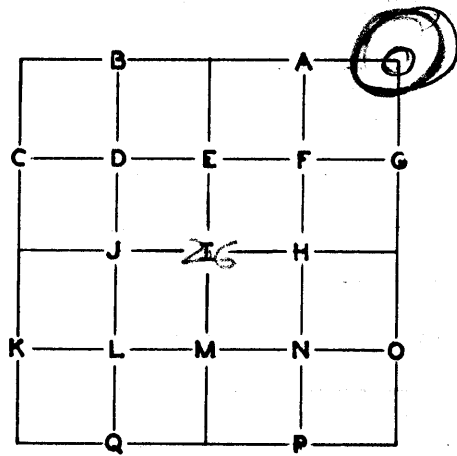

GLO SURVEY RECORD

DATE: 1900
CORNER Stone

PRESENT CONDITION - (DESCRIBE FULLY - USE PAGE 2 IF NEEDED FOR EXPLANATION.)

*Found Stone with Notches and with
23/24
26/25 on top.*

ACCESSORIES:

	BEARING-	LINKS-	FEET-
<i>10" Fir</i>	<i>N59 1/2 E</i>	<i>75</i>	<i>49.5</i>
<i>10" Hem.</i>	<i>S28E</i>	<i>13</i>	<i>8.6</i>
<i>7" Hem.</i>	<i>S21W</i>	<i>57</i>	<i>37.6</i>
<i>18" Hem.</i>	<i>N28W</i>	<i>16</i>	<i>10.6</i>

*12" Hem. Scribing Visible.
10" Hem. Stub 12' high.
10" Hem. Scribing Visible.
26" Hem. Scribing Visible.*

SURVEY RECORD
DATE:

PRESENT CONDITION:

CORNER SET: Stone set by GLO MAG. DECL: 20°


BEARING AND DISTANCE TO ABOVE IDENTIFIED SURVEY ACCESSORIES:

BEARING-	FEET-	SURVEY-
<i>N61E</i>	<i>49.5</i>	<i>GLO</i>
<i>S25E</i>	<i>38.4</i>	<i>GLO</i>
<i>S16W</i>	<i>9.3</i>	<i>GLO</i>
<i>N28W</i>	<i>9.6</i>	<i>GLO</i>

*12" Scribed Hem.
10" Hem. Stub 12' high.
10" Hem. Scribed.
26" Scribed Hem.*

CS53/112-91

SECTION 26 TOWNSHIP 25S RANGE 2W

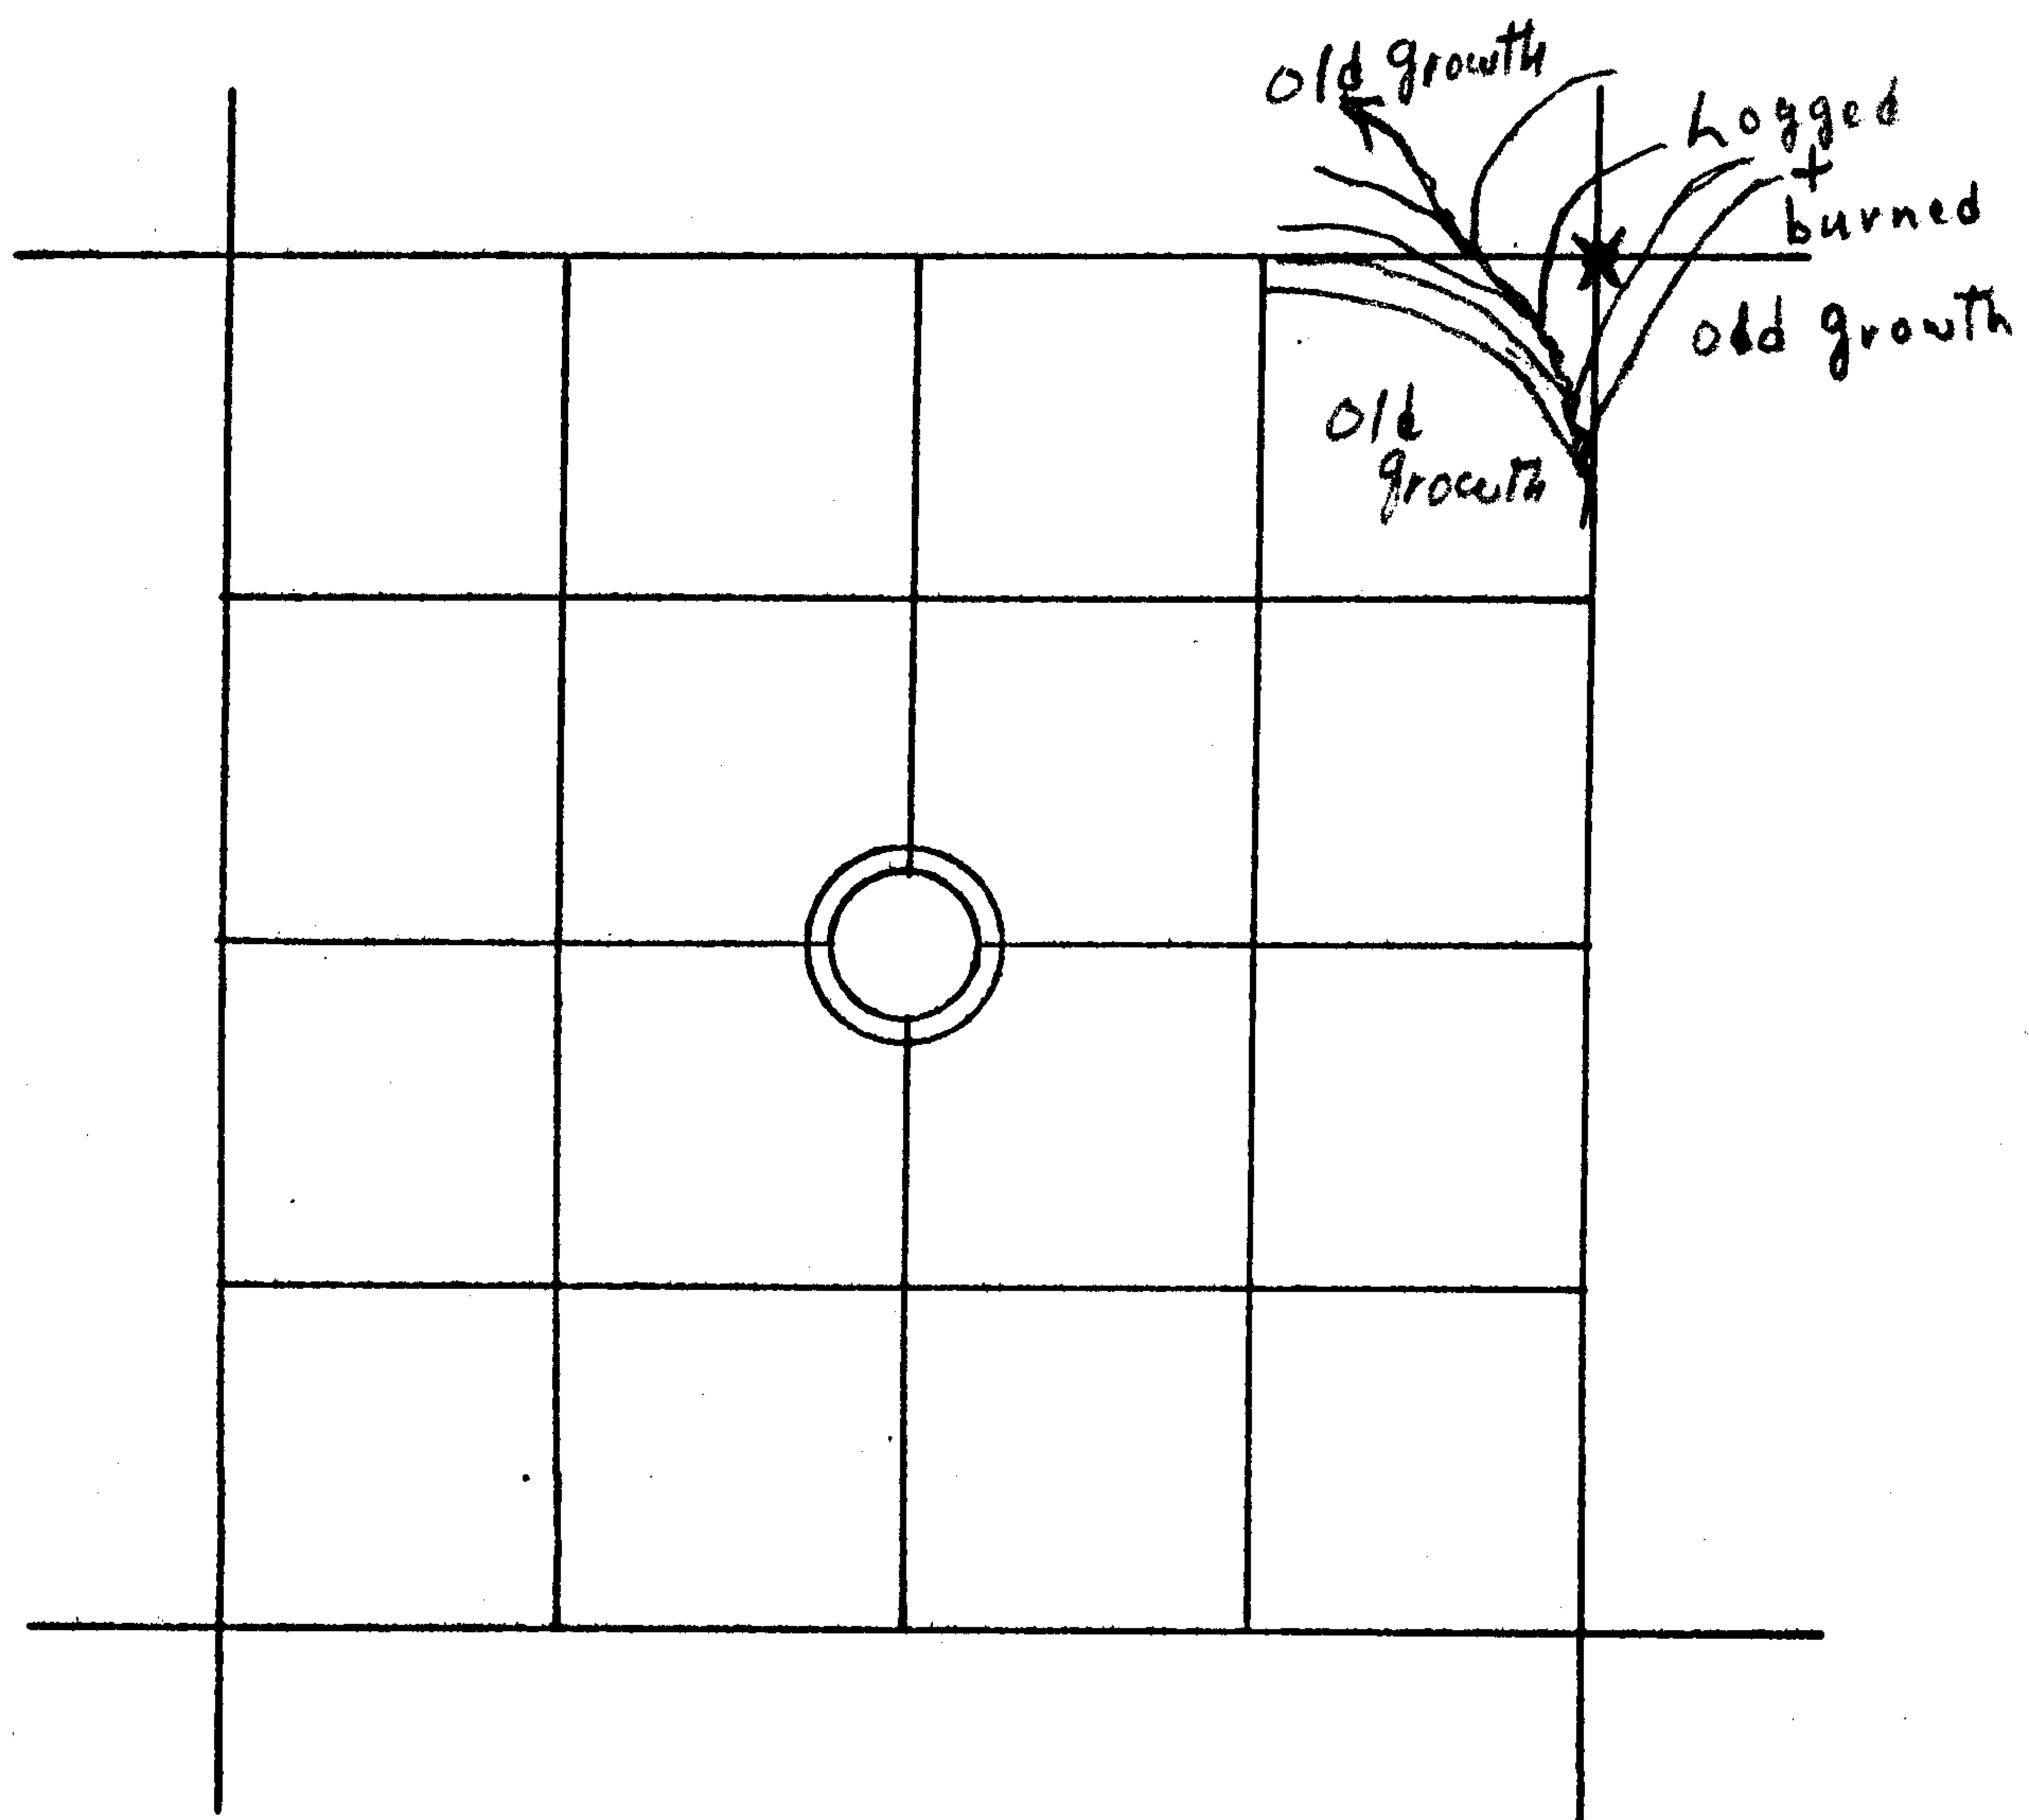

—||—||—||— LINE MARKED BY NOTCH CUT IN BLAZE.

○--- KNOWN CORNER.

⊗--- REFERENCED CORNER BY WEYERHAEUSER METHOD.

ACCESSORIES ADDED THIS DATE:

MAGNETIC DECLINATION 20°

	BEARING	FEET	ORIG. B.T.	"W" NAIL	PLATE	BRASS DISC
10" Hem.	N61E	49.2	X	X	X	—
38" Hem.	S88E	38.5	—	X	X	—
18" Ced.	S14W	27.0	—	X	X	
26" Hem.	N31W	8.9	X	X	X	

IDENTIFIED ON PHOTO: No

INFORMATION ON LOCATION OF CORNER AS NOW SET:

GROUND COVER: Rhododendron, SW corner of logging, slash burned.

(USING FORM LINES SKETCH TOPOG AT CORNER ON PAGE 2 PLAT)

SLOPE FACES (GIVE BEARING IN DEGREES) N75°W ON MINUS (-) 14 %

NORTH: -14° to 55', logged to East, old growth to West.

FROM CORNER -

SOUTH: +5° to old growth to East and West.

EAST: +20° to logged to North, old growth to South.

WEST: -15° to 30' then -60° to 160' to Cr. C N35W.

WORK DONE FOR W. T. CO.:

FIELD NOTES IN BOOK: _____

BY: Glen McChesney
ENGINEER - SURVEYOR

DATE: Aug. 16, 1958

UNDER THE SUPERVISION OF:

ASSISTED BY: _____

COPIES SENT TO: _____

SEAL