

26


PUBLIC LAND CORNERS

WEYERHAEUSER TIMBER COMPANY
SPRINGFIELD BRANCH

TOWNSHIP 25S RANGE 2W

SECTION 26 CORNER W 1/4

COUNTY Douglas OREGON

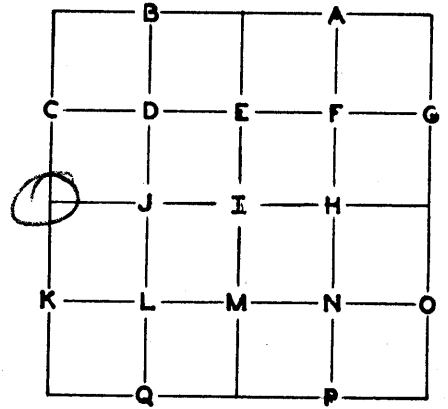

GLO SURVEY RECORD

DATE: 1900
CORNER Stone

PRESENT CONDITION - (DESCRIBE FULLY -
USE PAGE 2 IF NEEDED FOR EXPLANATION.)

Found. Marked 1/4 on W face.

ACCESSORIES:

	BEARING-	LINKS-	FEET-
<u>8" yew</u>	<u>S87E</u>	<u>32</u>	<u>21.1</u>
<u>5" yew</u>	<u>S80W</u>	<u>34</u>	<u>22.4</u>

9" yew. Scribing visible but face rotted.

Down.

SURVEY RECORD

DATE: _____

PRESENT CONDITION: _____

CORNER SET: Stone in Place


MAG. DECL: 20°

BEARING AND DISTANCE TO ABOVE IDENTIFIED SURVEY ACCESSORIES:

BEARING-	FEET-	SURVEY -	
<u>S87E</u>	<u>21.1</u>	<u>GLO</u>	<u>9" yew</u>
<u>S80W</u>	<u>22.4</u>	<u>"</u>	<u>down yew -</u>


CS 53/112-42

SECTION 26 TOWNSHIP 25S RANGE 2W

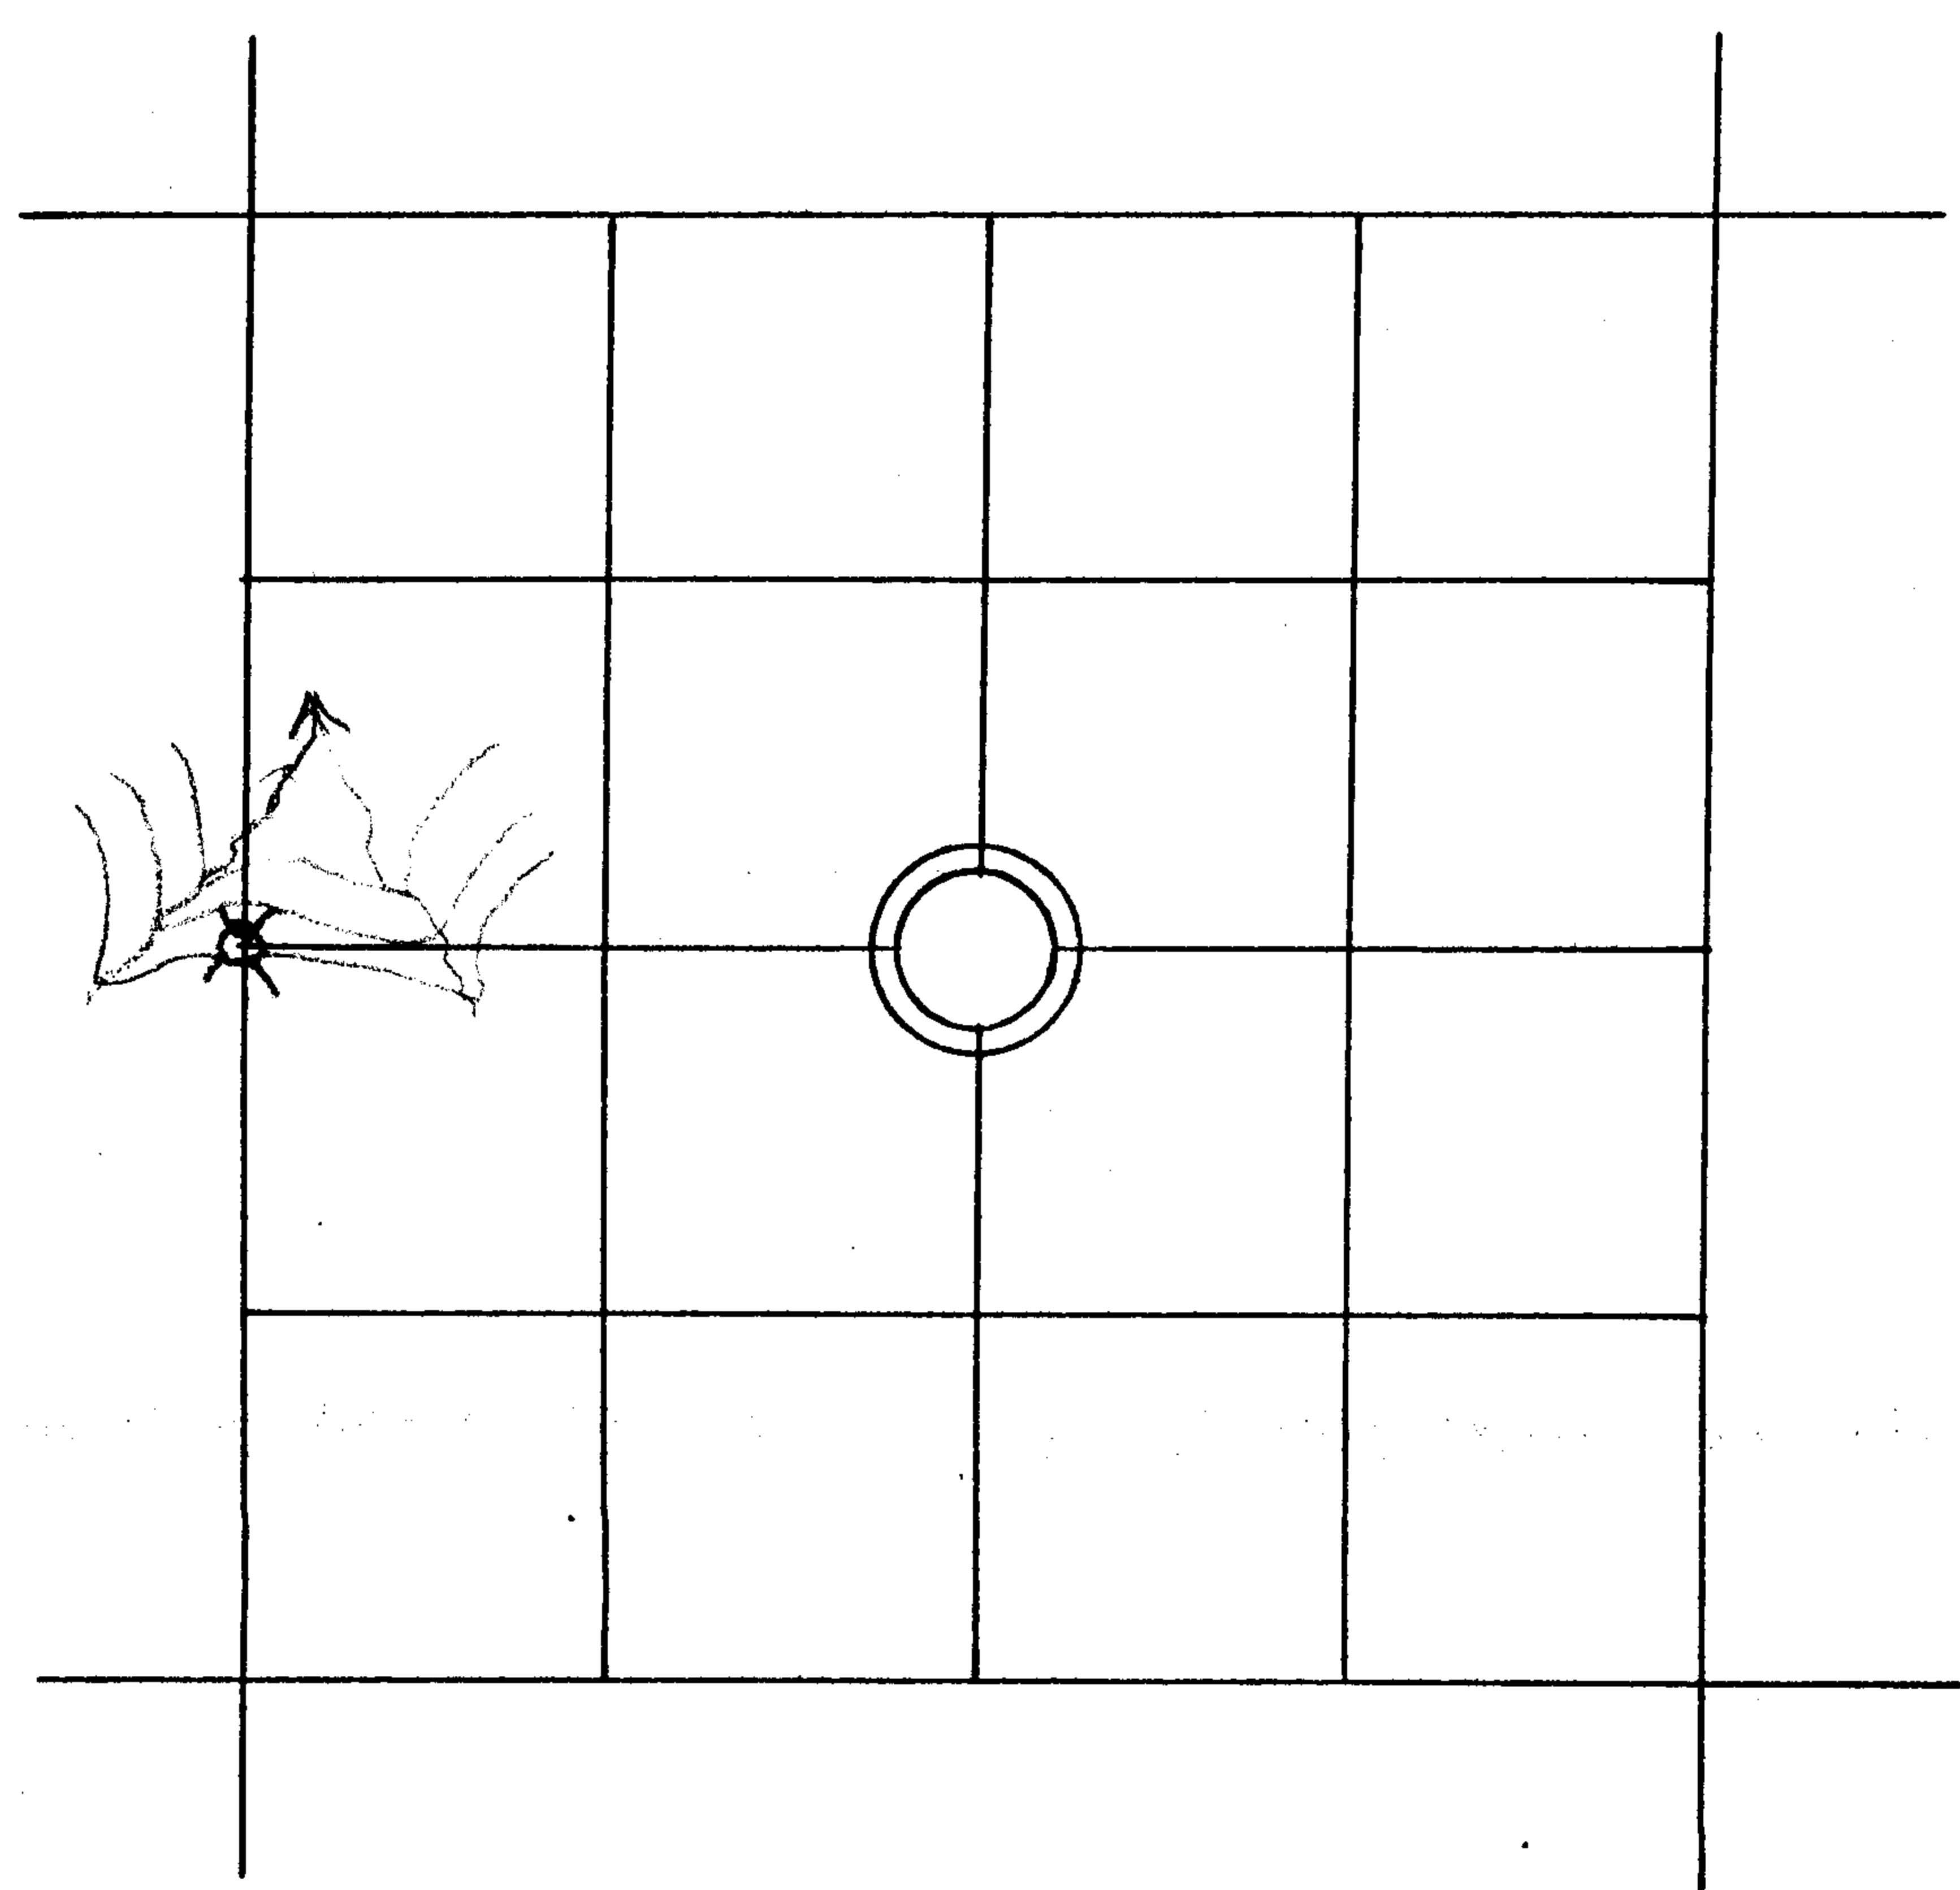

 LINE MARKED BY NOTCH CUT IN BLAZE.

 --- KNOWN CORNER.

 --- REFERENCED CORNER
BY WEYERHAEUSER
METHOD.

ACCESSORIES ADDED THIS DATE:

MAGNETIC DECLINATION 20°

	BEARING	FEET	ORIG. B.T.	"W" NAIL	PLATE	BRASS DISC
36" Fir.	S17W	25.5	—	X	X	—
18" Hem.	S50E	31.0	—	X	X	

IDENTIFIED ON PHOTO:

INFORMATION ON LOCATION OF CORNER AS NOW SET:

GROUND COVER: Sabal, sword fern

(USING FORM LINES SKETCH TOPOG AT CORNER ON PAGE 2 PLAT)

SLOPE FACES (GIVE BEARING IN DEGREES) North ON MINUS (-) 15 %

FROM CORNER -

NORTH: -15° 12' then -65° draw CNE old growth

SOUTH: +43° " "

EAST: Level 30'; -18° 90' " "

WEST: -12° 15'; -32° 40' to draw CNE

WORK DONE FOR W. T. CO.:

FIELD NOTES IN BOOK: _____

BY: Glen McChesney DATE: July 29, 1958
ENGINEER - SURVEYOR

UNDER THE SUPERVISION OF:

ASSISTED BY: _____

COPIES SENT TO: _____