

PUBLIC LAND CORNERS


PAGE 3

WEYERHAEUSER TIMBER COMPANY
 SPRINGFIELD BRANCH

TOWNSHIP 265 RANGE 2 W

SECTION 6 CORNER SW

COUNTY Douglas OREGON

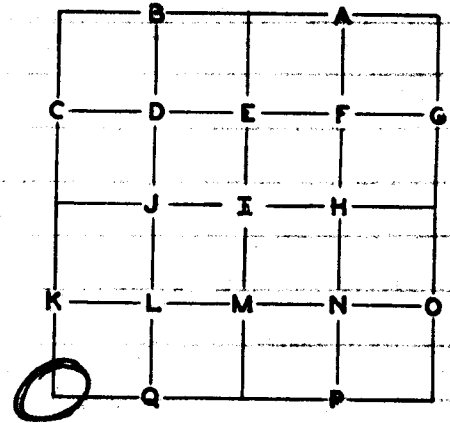

GLO SURVEY RECORD
 Retracement
 CORNER Stone

DATE: 1913

PRESENT CONDITION - (DESCRIBE FULLY -
 USE PAGE 2 IF NEEDED FOR EXPLANATION.)

Not found

ACCESSORIES:

	BEARING-	LINKS-	FEET-
<u>13" Cedar</u>	<u>N68E</u>	<u>30</u>	<u>19.8</u>
<u>8" Cedar</u>	<u>S60E</u>	<u>15</u>	<u>9.9</u>
<u>15" Cedar</u>	<u>S60W</u>	<u>30</u>	<u>19.8</u>
<u>16 Fir</u>	<u>N46W</u>	<u>88</u>	<u>58.1</u>

Down, rotted.
Destroyed by "cat".
30" Incense Cedar. Face.
28" Fir. Scribing visible.

SURVEY RECORD
 DATE: _____

PRESENT CONDITION: _____

CORNER SET: 1 1/2 Iron Pipe

MAG. DECL: 20°

Set by distance from SW and NW BT's

BEARING AND DISTANCE TO ABOVE IDENTIFIED SURVEY ACCESSORIES:


BEARING-	FEET-	SURVEY-
<u>N69E</u>	<u>20.0</u>	<u>1913</u>
<u>S64W</u>	<u>19.8</u>	<u>1913</u>
<u>N43W</u>	<u>58.1</u>	<u>1913</u>

Root hole down cedar.
30" Incense Cedar.
28" Fir.

Cs 53/114-2


Page 2

SECTION 6 TOWNSHIP 26S RANGE 2W

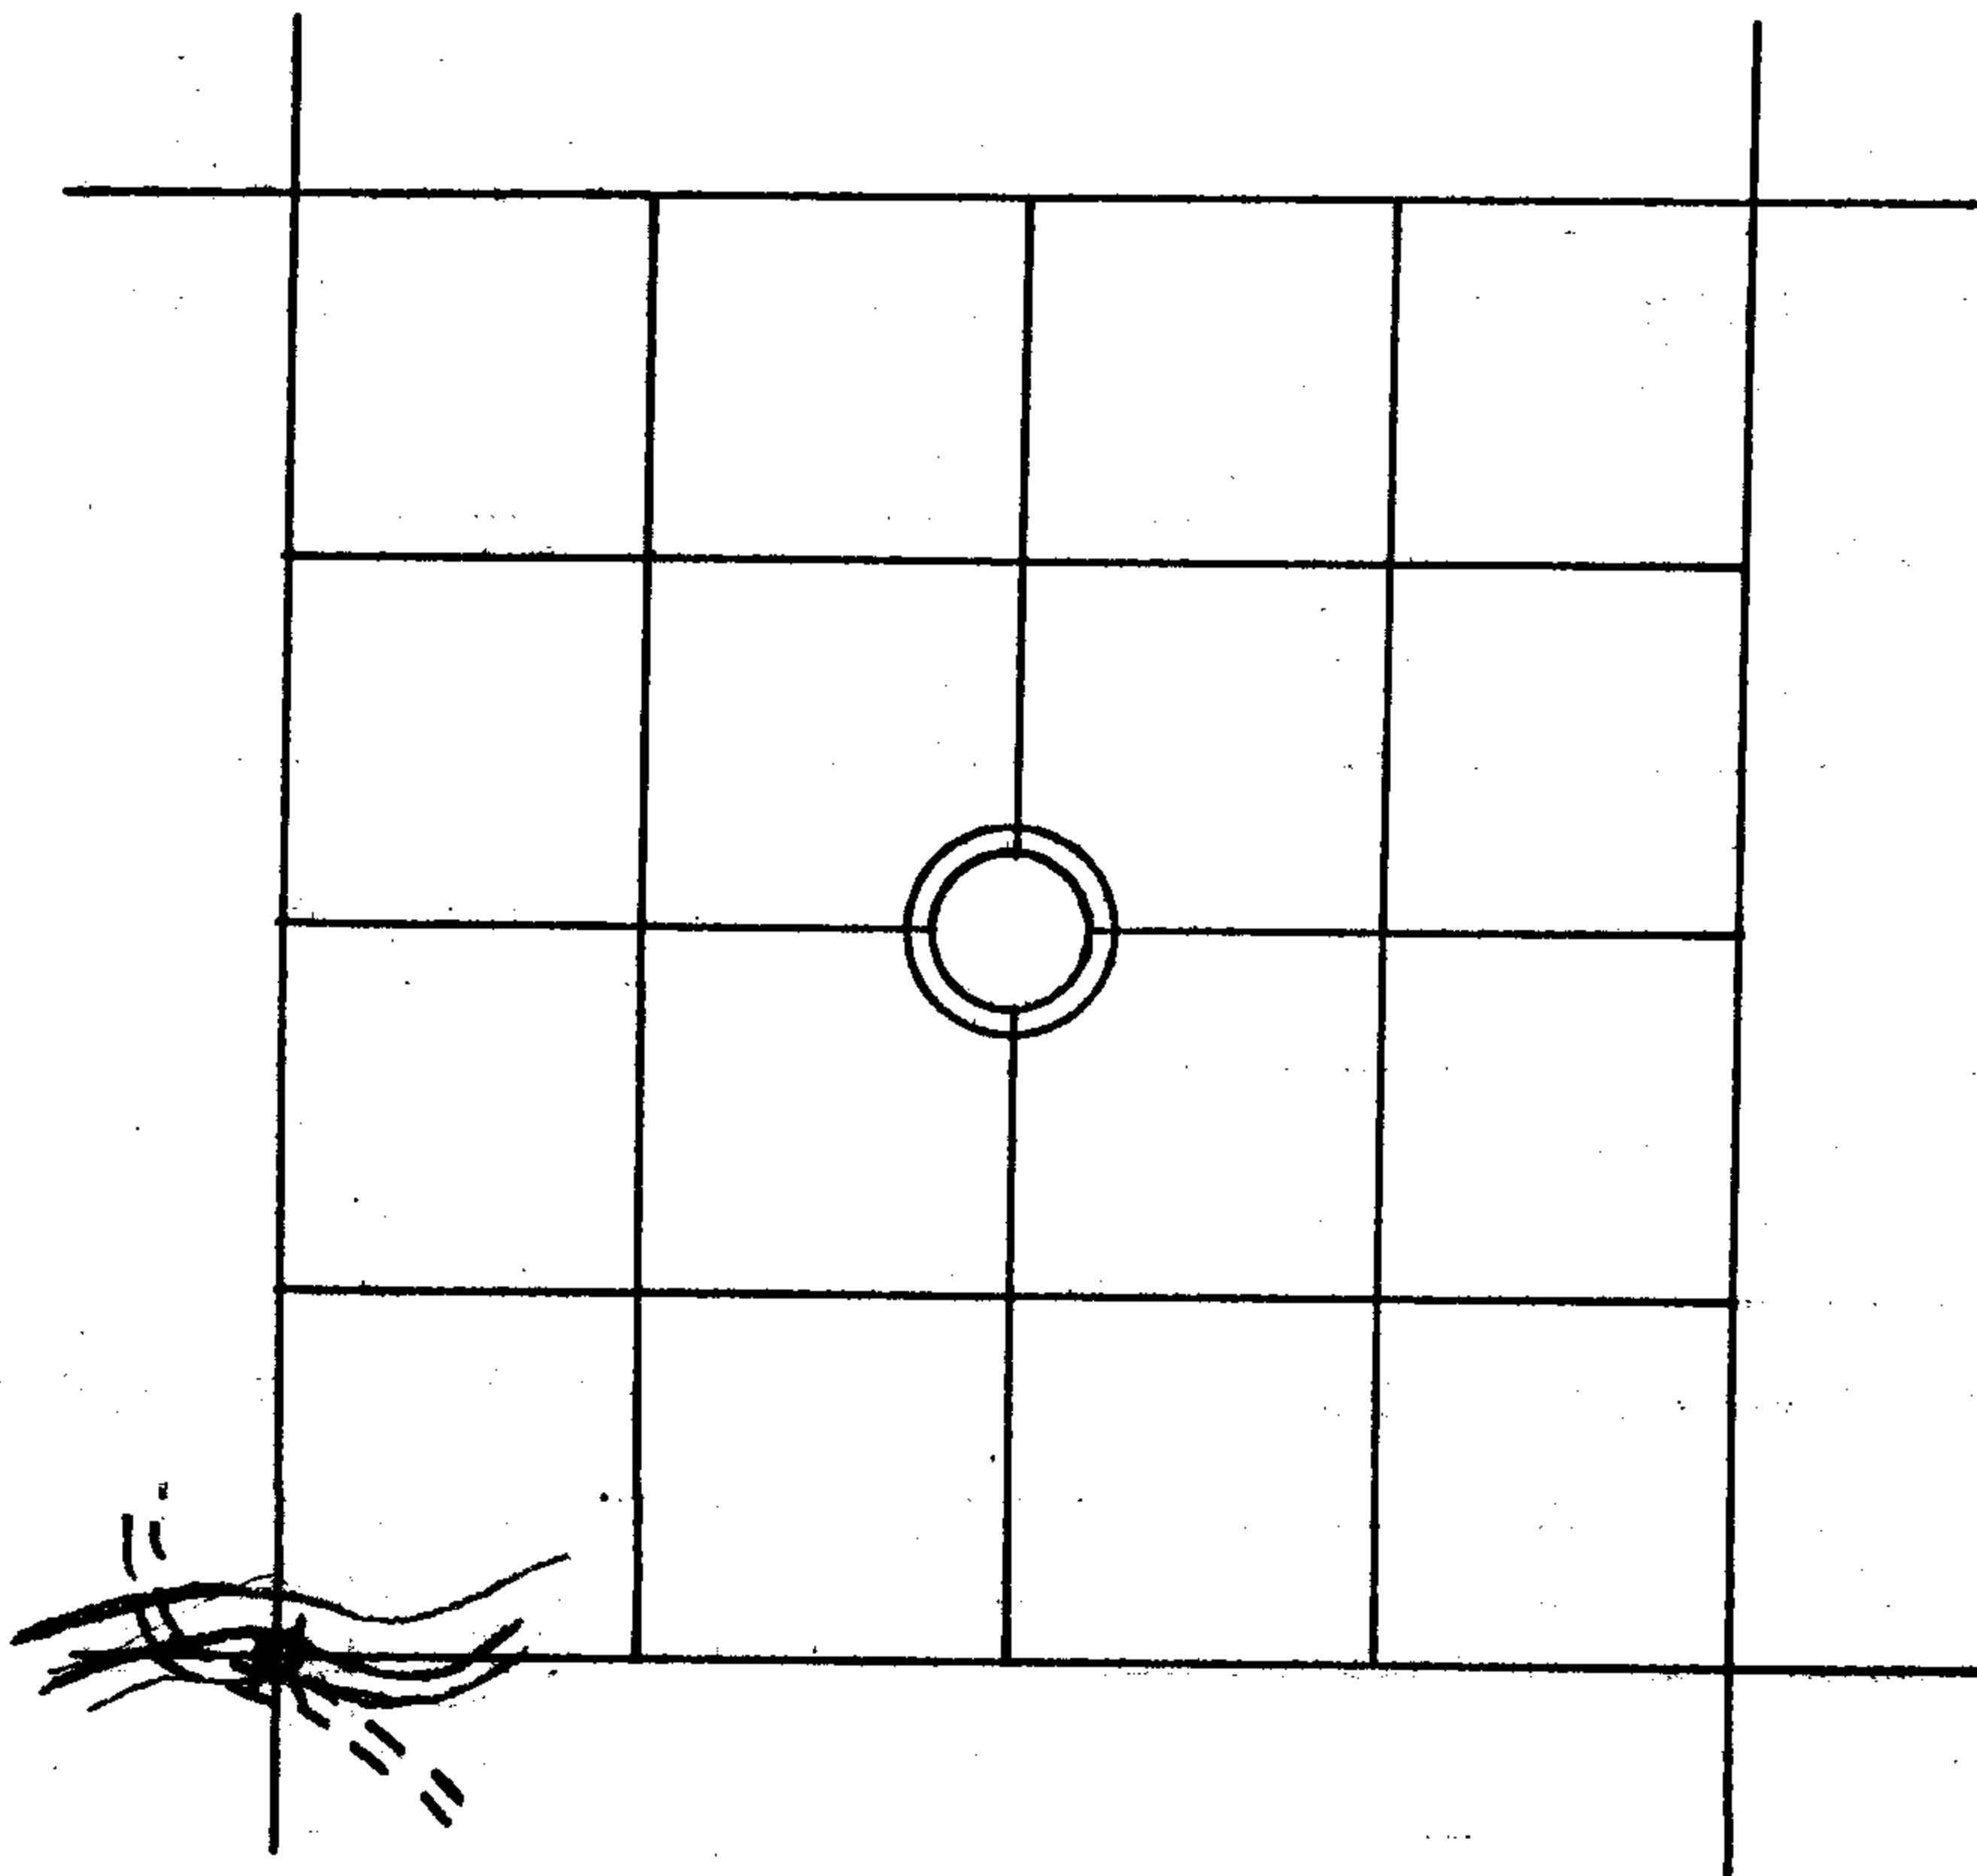

 LINE MARKED BY NOTCH CUT IN BLAZE.

 --- KNOWN CORNER.

 --- REFERENCED CORNER
BY WEYERHAEUSER
METHOD.

ACCESSORIES ADDED THIS DATE:

MAGNETIC DECLINATION 20°

	BEARING	FEET	ORIG. B.T.	"W" NAIL	PLATE	BRASS DISC
12" Hemlock	N37E	11.5	—	X	X	—
12" Incense Cedar	S73E	26.4	—	X	X	—
30" Incense Cedar	S64W	19.8	X	X	X	—
28" Fir	N43W	58.1	X	X	X	—

IDENTIFIED ON PHOTO:

INFORMATION ON LOCATION OF CORNER AS NOW SET:

GROUND COVER: Chinquapiñ and Salal

(USING FORM LINES SKETCH TOPOG AT CORNER ON PAGE 2 PLAT)

SLOPE FACES (GIVE BEARING IN DEGREES) South ON MINUS (-) 33 %

FROM CORNER -

NORTH: +22° 50'; +35° 250', 1958 logging to West and Old growth to East.

SOUTH: -33° 30' to dirt logging road.

EAST: Level 30' then +23°. Old growth to N + S.

WEST: Level 50' road, 1958 logging to N.

WORK DONE FOR W. T. CO.:

FIELD NOTES IN BOOK:

BY: Glen Mc Chesney DATE: July 29, 1958
ENGINEER - SURVEYOR

UNDER THE SUPERVISION OF:

ASSISTED BY:

COPIES SENT TO:

SEAL