


PUBLIC LAND CORNERS

WEYERHAEUSER TIMBER COMPANY
 SPRINGFIELD BRANCH

TOWNSHIP 26S RANGE 2W

SECTION 6 CORNER W 1/4

COUNTY Douglas OREGON

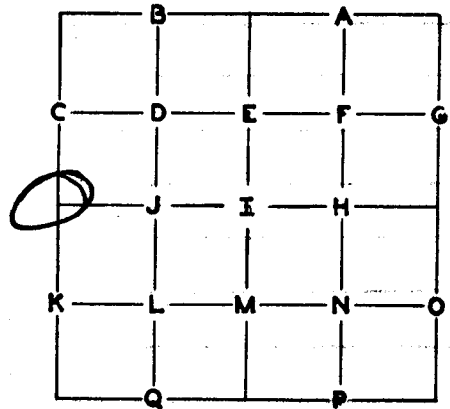

GLO SURVEY RECORD

DATE: 1855
 CORNER Post

PRESENT CONDITION - (DESCRIBE FULLY -
 USE PAGE 2 IF NEEDED FOR EXPLANATION.)

No trace

ACCESSORIES:

	BEARING-	LINKS-	FEET-	
<u>60" Fir</u>	<u>S50W</u>	<u>15</u>	<u>9.9</u>	<u>Rotted remains</u>
<u>18" Fir</u>	<u>S88E</u>	<u>22</u>	<u>14.5</u>	<u>Bark Scribed-</u>

Retracement SURVEY RECORD
 DATE: 1913

PRESENT CONDITION: _____

Squared Post
Corner located by reference to original
SE BT.
SW BT down + rotted - post destroyed
Witnessed by orig. BT:
24" Fir - S88E - 22 lks. 14.5

Not found

Rotted remains

Bark Scribed


CORNER SET: Post - Set S88E-14.5' from MAG. DECL: 20°
orig. SE BT as done in 1913 Retracement. (See Page 2)

BEARING AND DISTANCE TO ABOVE IDENTIFIED SURVEY ACCESSORIES:

BEARING-	FEET-	SURVEY-	
<u>S88E</u>	<u>14.5</u>	<u>1855-1913</u>	<u>Bark Scribed</u>
<u>N85W</u>	<u>10.0</u>	<u>1855</u>	<u>Rotted remains</u>

CS 53/114-4

Rec'd

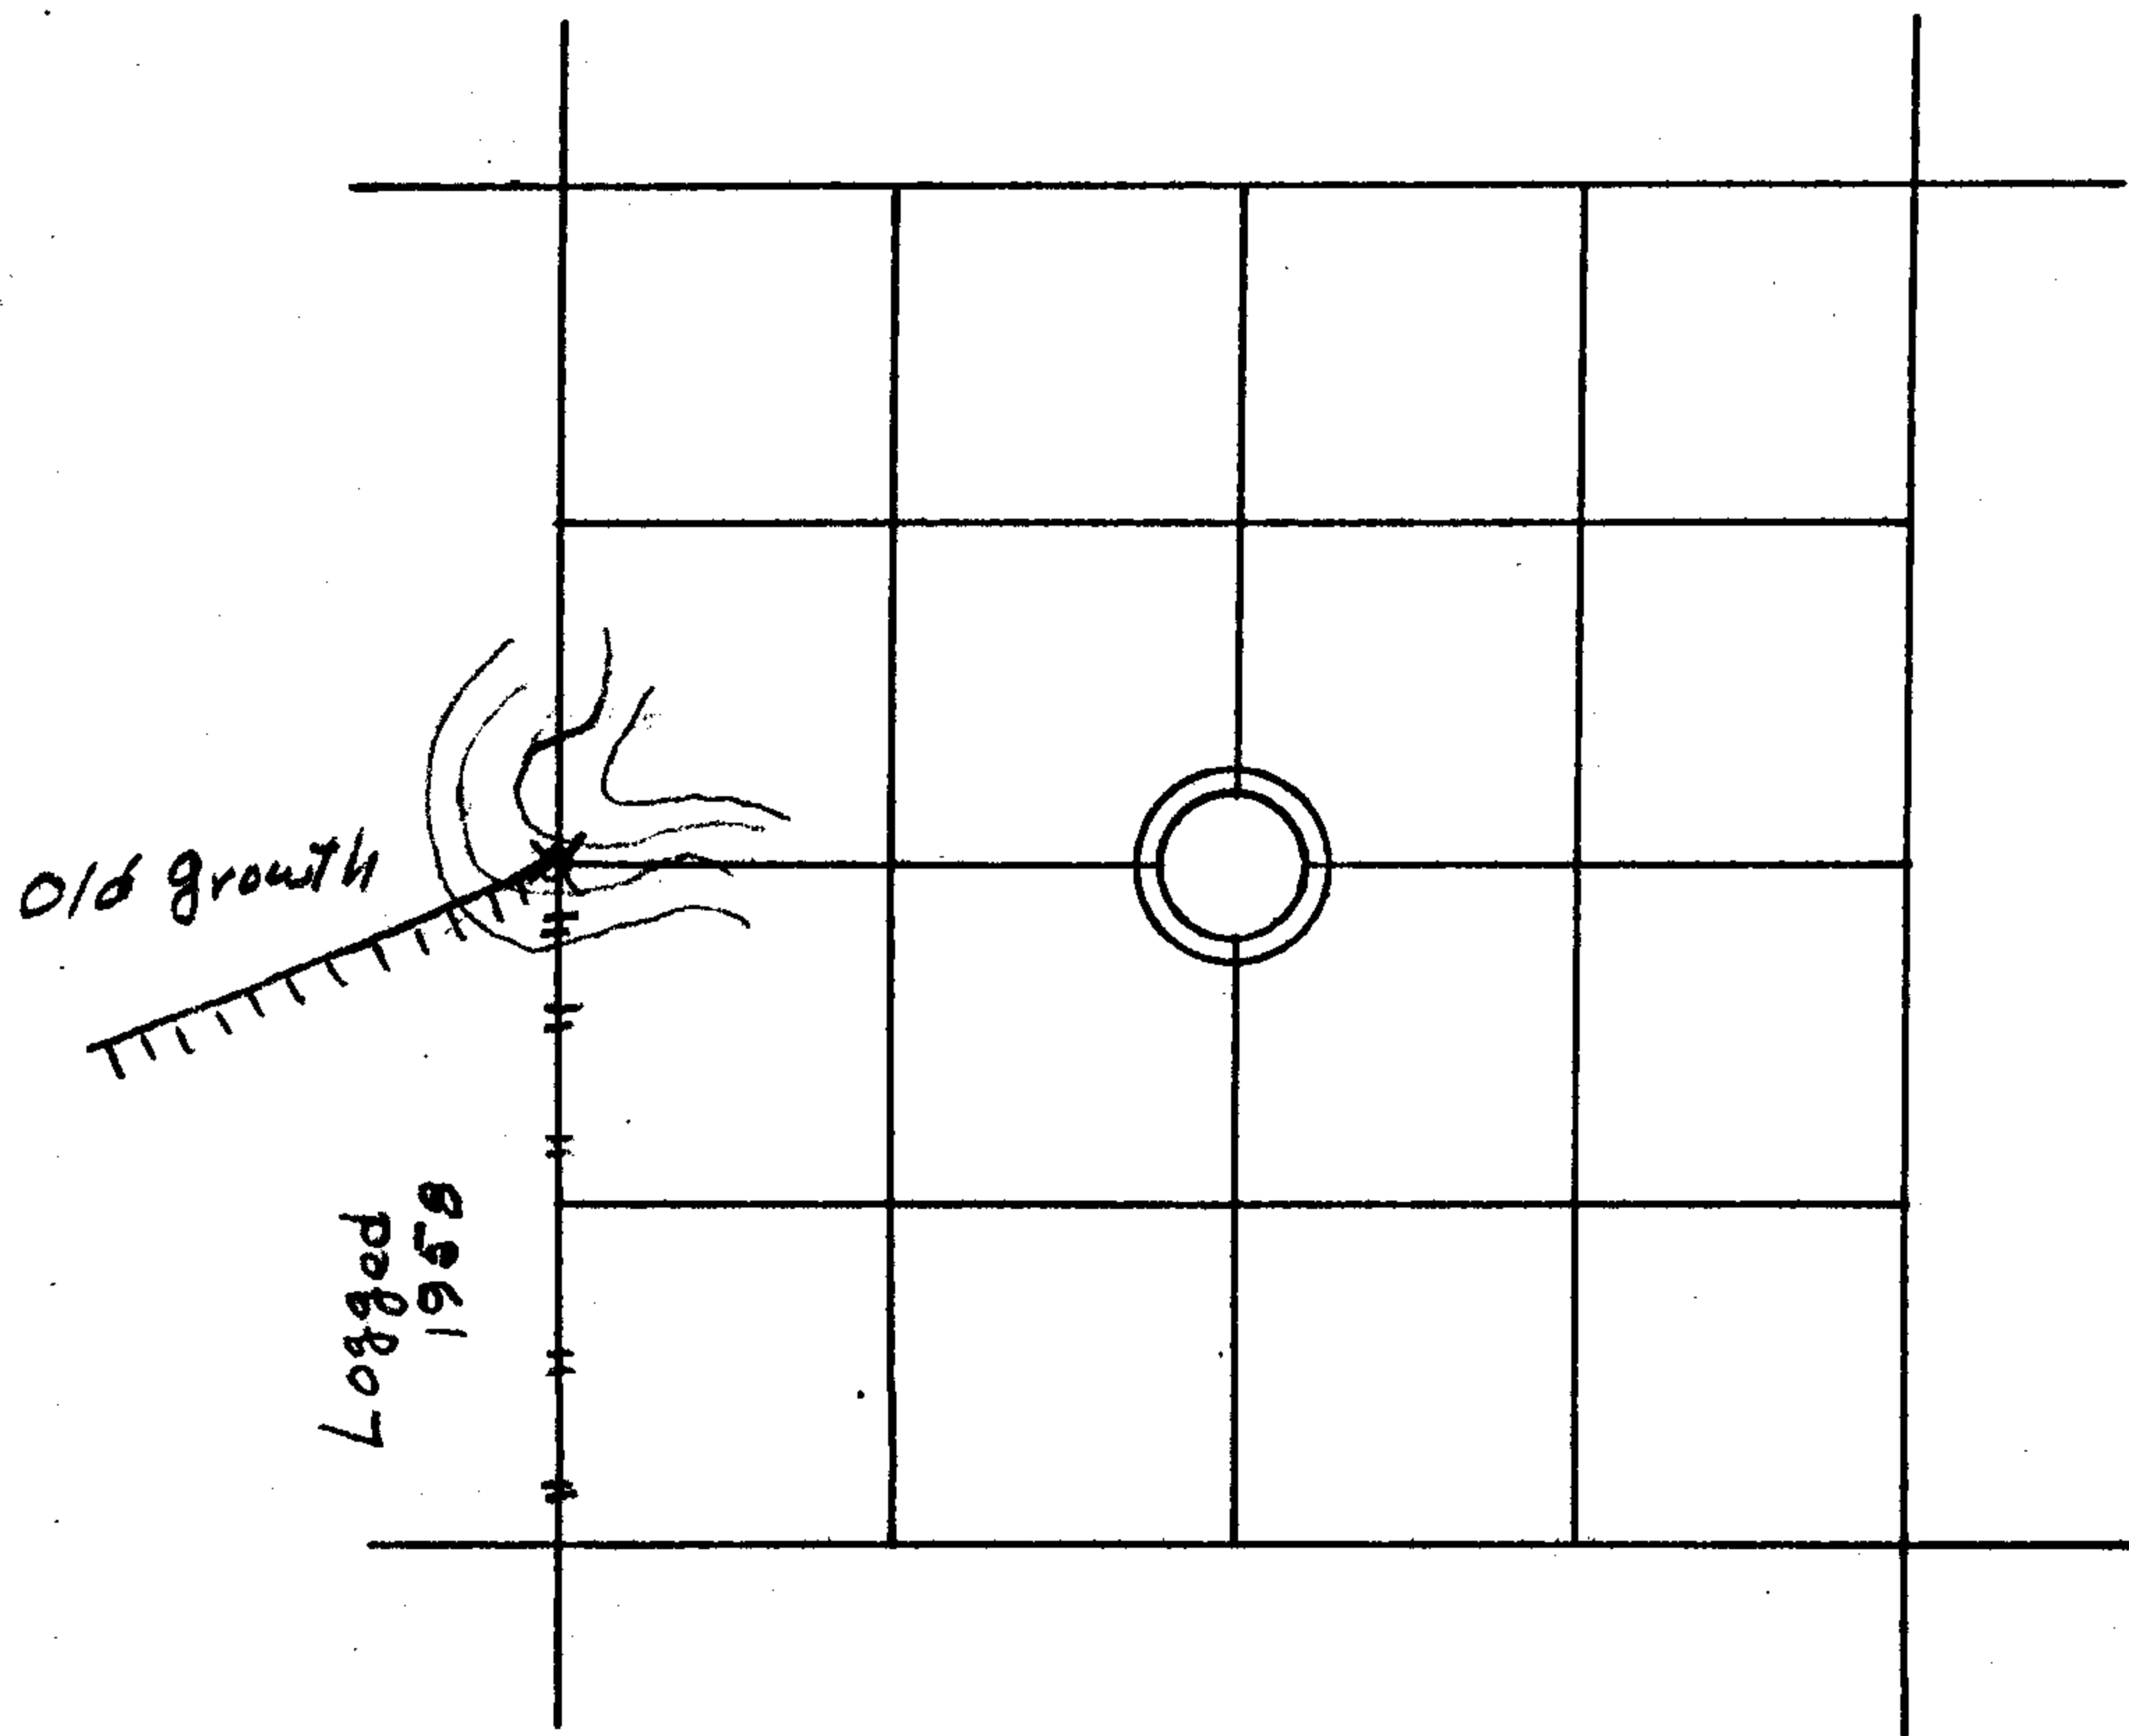

—||—||—||— LINE MARKED BY NOTCH CUT IN BLAZE.

○...KNOWN CORNER.

⊗...REFERENCED CORNER BY WEYERHAEUSER METHOD.

I found a square Cedar post from which SE BT bears S 74 E 145' instead of S 88 E. Remains of 60" Stamp bear S 80 W - 90' instead of S 55 W. I set and referenced Cor by distance and bearing from SE BT only.

I found a 48" Fir - North - 27.4' Jack-Knife scribed 1/4 S CSBT

ACCESSORIES ADDED THIS DATE:

MAGNETIC DECLINATION 20°

	BEARING	FEET	ORIG. B.T.	"W" NAIL	PLATE	BRASS DISC
48" Fir	N2W	27.4	—	X	X	—
16" Red Cedar	S55E	28.0	—	X	X	—

IDENTIFIED ON PHOTO:

INFORMATION ON LOCATION OF CORNER AS NOW SET:

GROUND COVER: Fern, Oregon Grape

(USING FORM LINES SKETCH TOPOG AT CORNER ON PAGE 2 PLAT)

SLOPE FACES (GIVE BEARING IN DEGREES) N40E ON MINUS (-) 18 %

NORTH: -18° 20'; Level 85' then descend. Old growth

FROM CORNER - SOUTH: Level 15' then -30° 75'. Old growth to East, 1958 logging to West.

EAST: Level 15' then -7° 65' then level. Old growth.

WEST: +4° 15' then -15°. Old growth to North. Cutting line to West bears S65W.

WORK DONE FOR W. T. CO.:

FIELD NOTES IN BOOK: _____

BY: Glen McChesney DATE: July 29, 1958
ENGINEER - SURVEYOR

UNDER THE SUPERVISION OF:

ASSISTED BY: _____

COPIES SENT TO: _____

SEAL