


PUBLIC LAND CORNERS

WEYERHAEUSER COMPANY
SPRINGFIELD BRANCH

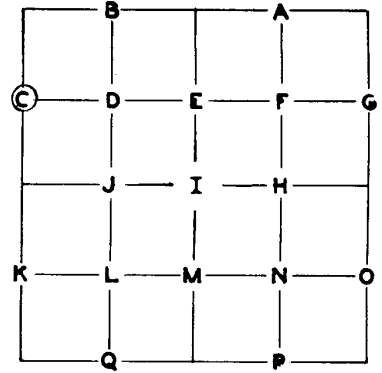

TOWNSHIP 26S RANGE 3W
SECTION 14 CORNER N¹/₁₆ "C"
COUNTY Douglas OREGON

GLO SURVEY RECORD				PRESENT CONDITION - (DESCRIBE FULLY - USE PAGE 2 IF NEEDED FOR EXPLANATION.)	
DATE: <u>1962</u>					
CORNER <u>Brass cap</u>					
ACCESSORIES:					
	BEARING-	LINKS-	FEET-		
<u>17" Fir</u>	<u>N77°E</u>	<u>62</u>	<u>40.9</u>	<u>18" Fir scribing visible</u>	
				<u>BLM Bearing Tree plate</u>	
<u>26" Cedar</u>	<u>N75¹/₂°W</u>	<u>43</u>	<u>28.4</u>	<u>26" Incense Cedar - scribing visible -</u>	
				<u>BLM Bearing Tree plate</u>	
SURVEY RECORD				PRESENT CONDITION:	
DATE: _____				_____	

CORNER SET: Brass cap as found MAG. DECL.: 20°

BEARING AND DISTANCE TO ABOVE IDENTIFIED SURVEY ACCESSORIES:

BEARING-	FEET-	SURVEY -	
<u>N77°E</u>	<u>40.9</u>	<u>1962</u>	<u>Distance to center of BT</u>
<u>N75°W</u>	<u>29.0</u>	<u>1962</u>	<u>Distance to center of BT</u>

ACCESSORIES ADDED THIS DATE:

MAGNETIC DECLINATION 20°

	BEARING	FEET	ORIG. B.T.	"W" NAIL	PLATE	BRASS DISC
26" Incense Cedar	N73°W	27.7	1962 GLO	X	X	
28" Incense Cedar	N 9°E	14.0	-	X	X	

IDENTIFIED ON PHOTO:

INFORMATION ON LOCATION OF CORNER AS NOW SET:

GROUND COVER: Ironwood, saial

(USING FORM LINES SKETCH TOPOG AT CORNER ON PAGE 2 PLAT)

SLOPE FACES (GIVE BEARING IN DEGREES) S65°W ON MINUS (-) 35 %

FROM CORNER |

NORTH: + 5%

SOUTH: - 20%

EAST: + 32%

WEST: - 30%

WORK DONE FOR W. CO.

FIELD NOTES IN BOOK:

BY: Glen McChesney DATE: 10/8/69
~~ENGINEER SURVEYOR~~

ASSISTED BY: Kenneth Perkins

COPIES SENT TO:

UNDER THE SUPERVISION OF:

SEAL PAGE 3