


# PUBLIC LAND CORNERS

WEYERHAEUSER TIMBER COMPANY  
 SPRINGFIELD BRANCH

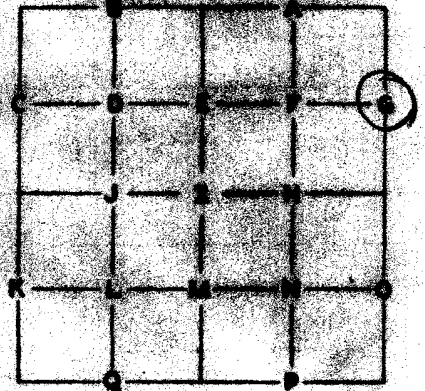

TOWNSHIP 26 S RANGE 3 W

SECTION 2 CORNER E 1/16 E LINE

COUNTY DOUGLAS OREGON

## GLO SURVEY RECORD

DATE: \_\_\_\_\_  
 CORNER \_\_\_\_\_

PRESENT CONDITION - (DESCRIBE FULLY  
 USE PAGE 2 IF NEEDED FOR EXPLANATION.)

### ACCESSORIES:

	BEARING-	LINKS-	FEET-

W.T.Co.

## SURVEY RECORD

DATE: AUGUST 21, 1943

### PRESENT CONDITION:

FOUND POST

12" FIR     S 18° W     12.5'

16" FIR - FOUND PLATE - NO "W" MARK

CORNER SET: POST

MAGNETIC DECLINATION: 20°

### BEARING AND DISTANCE TO ABOVE IDENTIFIED SURVEY ACCESSORIES:

BEARING-	FEET-	
<u>S 18° W</u>	<u>12.5</u>	<u>16" FIR</u>

*CS 53/115-19*

ACCESSORIES ADDED THIS DATE

	BEARING-	FEET	ORIG. BT	"W" NAIL	PLATE	BRASS DISC
16" FIR	S 19° W	11.1		X	X	
12" FIR	N 13° W	24.5		X	X	

IDENTIFIED ON PHOTO:

INFORMATION ON LOCATION OF CORNER AS NOW SET:

DESCRIPTION OF GROUND COVER AND GROUND SLOPE AT CORNER: ON HILLSIDE FACED

SOUTHEAST IN EDGE 50 YR ONE ROWTH

FROM CORNER NORTH: 10-20 YR FIR AND GROWTH TO WEST AND TO EAST

SOUTH: CLEAR CUT TO EAST 50-70 YR FIR TO WEST

EAST: CLEAR CUT - APPROX. 100 FT TO DRAW

WEST: 50-70 YR ONE ROWTH 300 FT TO A XUS OPENING

WORK DONE FOR W. T. CO.

BY: Mc Chesney  
ENGINEER - SURVEYOR

DATE: OCTOBER 9, 1952

ASSISTED BY: \_\_\_\_\_

UNDER SUPERVISION OF: \_\_\_\_\_

COPIES SENT TO: \_\_\_\_\_