


# PUBLIC LAND CORNERS

WEYERHAEUSER TIMBER COMPANY  
 SPRINGFIELD BRANCH

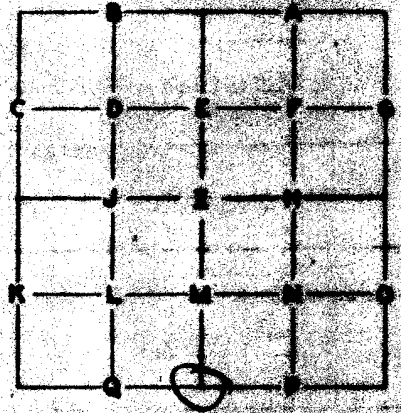

TOWNSHIP 26 S RANGE 3 E

SECTION 12 CORNER S 1/4

COUNTY DOUGLAS OREGON

## GLO SURVEY RECORD

DATE: 1879

CORNER CEDEAR POST

PRESENT CONDITION - (DESCRIBE FULLY -  
 USE PAGE 2 IF NEEDED FOR EXPLANATION)

### ACCESSORIES:

	BEARING-	LINKS-	FEET-
42° FIR	N 52° E	47	31.0'
60° S. FINE	S 20° E	32	21.0'

42° FIR STUMP (TREE FILLED)  
 MARK SLIPPED. MARK SCREENING NECESSARY

U.S.G. SURVEY RECORD  
 DATE: SEPTEMBER 1946

42° FIR	N 52° E	31.0'	BT	PLATE
60° S. FINE	S 20° E	21.0'	BT	PLATE

PRESENT CONDITION:

42° FIR STUMP  
 MARK SLIPPED

NO REFERENCED - SEE PAGE 3

CORNER SET: POST - STONE

MAGNETIC DECLINATION: 30°

### BEARING AND DISTANCE TO ABOVE IDENTIFIED SURVEY ACCESSORIES:

BEARING-	FEET-

CS 53/115-21

ACCESSORIES ADDED THIS DATE:

	BEARING-	FEET	ORIG. BT	W <sup>2</sup> -NAIL	PLATE	BRASS DISC
42" PINE STUMP	N 51° E	30.3	X	X	X	
60" SUGAR PINE	S 26° E	20.6	X	X	X	

IDENTIFIED ON PHOTO:

INFORMATION ON LOCATION OF CORNER AS NOW SET:

DESCRIPTION OF GROUND COVER AND GROUND SLOPE AT CORNER: SALAL

CUTTING CORNER

FROM CORNER NORTH: + 15% 0% TO WEST, 0% TO EAST

SOUTH: - 30% 50' DEAW COURSE EAST 0%

EAST: - 20% 0% TO WEST, 0% TO EAST

WEST: + 5% 0%

WORK DONE FOR W. T. CO.

BY: Mc Chesney  
ENGINEER - SURVEYOR

DATE: OCTOBER 25, 1957

ASSISTED BY: \_\_\_\_\_

UNDER SUPERVISION OF: \_\_\_\_\_

COPIES SENT TO: \_\_\_\_\_

SEAL