


PUBLIC LAND CORNERS

**WEYERHAEUSER TIMBER COMPANY
SPRINGFIELD BRANCH**

TOWNSHIP 26 S RANGE 30 W
SECTION 2 CORNER C 1/4
COUNTY DOUGLAS OREGON

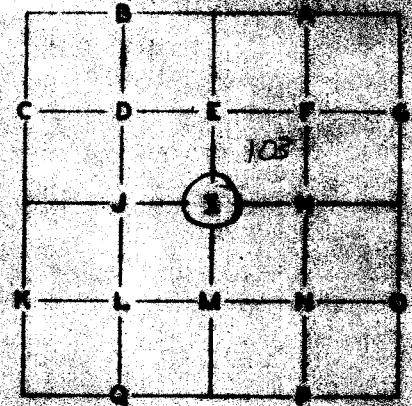

GLO SURVEY RECORD

DATE: OCTOBER 9, 1957

CORNER _____

PRESENT CONDITION - (DESCRIBE FULLY
USE PAGE 2 IF NEEDED FOR EXPLANATION.)

ACCESSORIES:

BEARING-	LINKS-	FEET-

W.T.Co. SURVEY RECORD
DATE: AUGUST 21, 1943

24" WHITE FIR N 55° W 28.7'

PRESENT CONDITION:

28" - 30' STUB BLAZE AND OLD TAG

CORNER SET: PIPE

MAGNETIC DECLINATION: 20°

BEARING AND DISTANCE TO ABOVE IDENTIFIED SURVEY ACCESSORIES:

BEARING-	FEET-	
<u>N 55° W</u>	<u>28.7</u>	<u>28" - 30' W. FIR STUB WITH OLD WT PLATE</u>

53/115-22

ACCESSORIES ADDED THIS DATE

	BEARING-	FEET	ORIG. BT	W ² -NAIL	PLATE	BRASS DISC
48" INCENSE CEDAR STUMP	S 5° W	24.9		X	X	

IDENTIFIED ON PHOTO:

INFORMATION ON LOCATION OF CORNER AS NOW SET:

DESCRIPTION OF GROUND COVER AND GROUND SLOPE AT CORNER: ON FLAT TOP RIDGE

WHICH BEARS NE AND SE. HAZEL & SALAL BUSHWOOD

FROM CORNER NORTH: DESCEND APPROX 160' TO DRAW C.C. TO WEST, CLEAR CUT TO EAST

SOUTH: CLEAR CUT TO EAST & WEST

EAST: CLEAR CUT TO NORTH AND SOUTH

WEST: CLEAR CUT TO SOUTH C.C. TO NORTH

WORK DONE FOR W. T. CO.

BY: Mc Chesney
ENGINEER - SURVEYOR

DATE: OCTOBER 9, 1957

ASSISTED BY: _____

UNDER SUPERVISION OF: _____

COPIES SENT TO: _____

SEAL