

Renew Township Cor. T205 R12W 336 R11W
T215 R12W 31

Ed. 2" Aluminum Pipe set from following O.B.T.s -

Orig. 15" Now approx. 30" Fir N. 5 1/2° E. 28 1/2 ft.
Now shattered stump with "T205 R11W 31 BT" scribe Revealed.

Orig. 15" Now 30" Fir S. 85° W. 40 1/2 ft.
Now 20 ft. high snag. Shows faint scribe


Orig. 12" Now 18" Fir N. 8 1/2° W. 31 1/2 ft.
Now badly decayed stump with fragmentary Reverse scribe MKs. - No Trace S.E. RT.

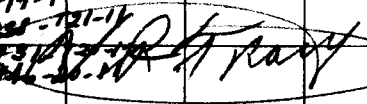
2 40" Fir Stump Bears N. 48° E. 40 1/2 ft.
MKd. "S 31 BT" Bark scribe - unrecorded.
we MK. New B.T. -

24" Hemlock N. 15 1/2° E. 30 1/2 ft.
MKd. "T205 R11W 31 CS BT"

No other trees close. This cor. lies on moderate S.E. slope approx. 100 ft. S. of Top of Ridge. Closing cor. Bears S. approx. 195 ft. - This area logged in recent years -

March 30, 1967

V.R.T. 
J.H.
D.W.

19-T21-12
20-T21-14
21-T21-15
22-T21-16
* 23-T21-17


C.S. File No. 54/1-3A