

Renew $\frac{1}{4}$ 520 & 521 T315 R7W

Fd. Both ORIGINAL BT's at COR

as follows -

14" Now 17" Laurel S. 39° E 21 $\frac{1}{2}$ ft.

we open & find face had rotted
before tree healed. - Face edges

show axe marks -

12" Now 16" Laurel N. 78° W. 35 $\frac{1}{2}$ ft.

DOWN & Dead - Fd Reverse " $\frac{1}{4}$ " scribe.

Set 1" I.P. & BRASS CAP MKD-

"COUNTY SURVEYOR'S OFFICE 1965

T315 R7W $\frac{1}{4}$ 520 & 521" & MK

New BT's -

10" D. FIR S. 47° W. 23 $\frac{1}{2}$ ft.

Mkd. " $\frac{1}{4}$ S 20 CS BT"

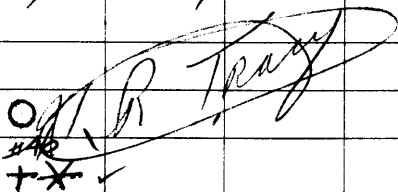
11" Pine N. 47° E. 29 $\frac{1}{2}$ ft.

Mkd. " $\frac{1}{4}$ S 21 CS BT"

This COR. lies on fairly steep
S.W. slope of SPUR Ridge approx.
200 $\frac{1}{2}$ ft south of Top.

April 16, 1965

J.R.T.
M.D.
J.B.


#40
+X ✓

C. S. File No. 54-304