


**DO NOT REMOVE FROM OFFICE**

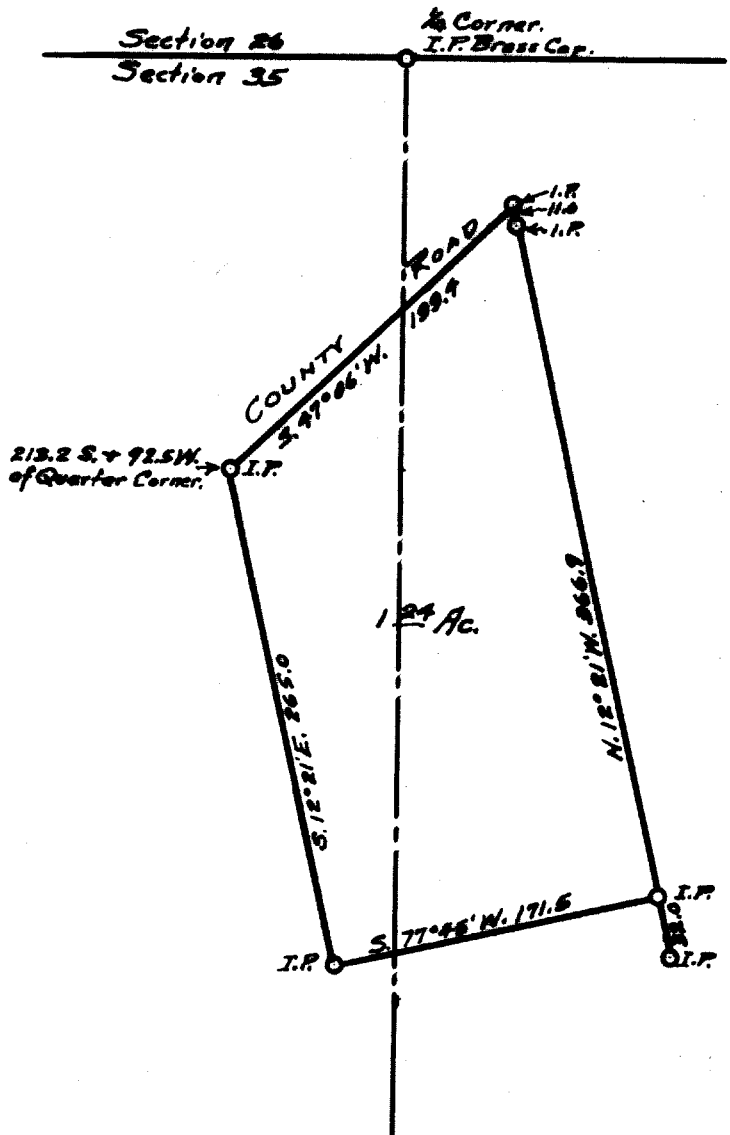

FILED   
RECEIVED

AUG 13 1965

COUNTY SURVEYOR  
DOUGLAS COUNTY, ORE.

COUNTY SURVEYOR'S OFFICE  
DOUGLAS COUNTY, OREGON.

SURVEY FOR  
C.E. YOUNG, SECTION 35, T. 32 S., R. 6 W.  
G.J. Wenderoth, Deputy. JUNE 1965  
Scale 1" = 100ft

REGISTERED  
OREGON  
LAND SURVEYOR



MARCH 10, 1944  
George J. Wenderoth  
5

SEE M 58-3

C.S. File No. 54/5-6