


Renew South M.C. of S. 9 T265 R3W
ON LEFT BANK OF N. Umpqua River Rd.
1924 GLO Brass Cap Firmly Set & MKd.
"SMC 59" & one BT as follows -
11" now 13" 25h South 15⁸ ft.
shows scribe on partially healed scar.
NO TRACE OTHER BT - we MARK new BT -
11" W. ORK S 65° E 22² FT.
MKd " SMC 59 CS BT "
This cor lies approx. 50 ft. NORTH
of Road course N.E. & S.W.

Jan, 27, 1966

V.R.T.
M.S.
J.L.

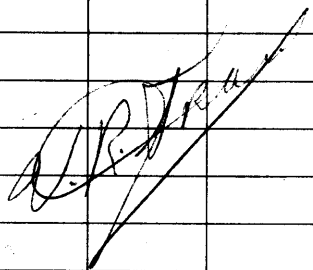

FILED
RECEIVED

Center line of Sec.

JAN 27 1966

COUNTY SURVEYOR
DOUGLAS COUNTY, ORE.

80
121
*

C. S. File No. 54/7-3