

Renew $\frac{1}{4}$ $\frac{531}{56}$ T255 R3W.
T265

Fd. I.P. & BRASS Cap set by G.L.O. in 1943

SURVEY MKD. $\frac{1}{4}$ $\frac{531}{56}$ Also find FIR

5 Tumps Referred to in Rev. #101 & B.T.s as follows -

11" D. FIR S. 11° E. 12 $\frac{3}{4}$ ft. - alive -
Face pitched over - we do not disturb.

13" D. FIR N. 4° W. 17 $\frac{1}{2}$ ft. - Dead.

BURNED - partial scribe visible.

We MARK new B.T. -

8" D. FIR N. 86° W. 51 $\frac{1}{2}$ ft.


MKD. $\frac{1}{4}$ 531 CS BT"

CORNER, is 70 ft. North of E.-W.

Fence & 20 ft. East of creek, course
South.

Feb 1, 1966

V.R.T.
M.S.
J.L.

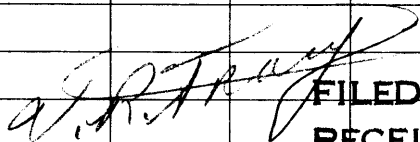

FILED
RECEIVED

FEB 1 1966

COUNTY SURVEYOR
DOUGLAS COUNTY, ORE.

*145. 126
*538 125

C.S. File No.

54/7-37