

Renew $\frac{1}{4}$ $\frac{57}{518}$ T265 R3W

Ed. Brass cap at cor. MKd. COUNTY

SURVEYOR'S OFFICE T265 R3W $\frac{1}{4}$ $\frac{57}{518}$ 1955"

& stump of BT's as Recorded in Ren. # 69.

as follows -

12" W. OAK. N. 67° W. 65 $\frac{8}{8}$ ft.

Burned. No scribe.

12" W. OAK. S. 11 $\frac{1}{2}$ ° W. 77° ft.

Shows "18 CS" Reverse.

We MK. New BT -

6" D. FIR S. 62° W. 40° ft.


Mkd. " $\frac{1}{4}$ S 18 CS BT "

No Trees to NORTH close.

Cor. Lies 30 ft. North of small
creek flowing S.E.

Feb. 21, 1966

V.R.T.
M.S.
J.H.

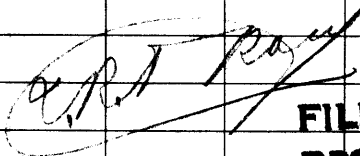

**FILED
RECEIVED**

FEB 21 1966

**COUNTY SURVEYOR
DOUGLAS COUNTY, OR.**

* 191-

C. S. File No. 54/755