

Renew $\frac{1}{4}$ $\frac{52}{511}$ T2 65 R3W

Fd. I.R. & BT's 25 Recorded in Renewals #
54 & 113 25 follows -

12" now 20" R. FIR S. 26° W. 35 4 FT.

Both Blazes healed - we do not open.

18" now 24" R. FIR N. 78 1/2° E. 26 5 FT.

Both Blazes healed - we do not open.

We set 1" I.P. & BRASS cap at cor.

point & set 5/8" I.R. along side. BRASS Cap

Mkd. "COUNTY SURVEYOR'S OFFICE 1966

T265 $\frac{1}{4}$ $\frac{52}{511}$ R3W" - we Build mound


of stone around pipe. COR. Lies

in old fence line running N. 10° W. -

S. 10° E.

Feb 25, 1966

U.R.T.
J.H.

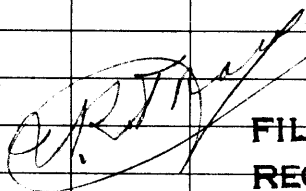

FILED
RECEIVED

FEB 25 1966

COUNTY SURVEYOR
DOUGLAS COUNTY, ORE.

#164

*

CS 54/7-56