

Renewal

AP4

(Sec 9)  
726S 33W

Found

12" W. Oak Now 15" N 19 1/2 W 75 F  
opened from Service P.B.

No Trace of <sup>GLD</sup> Brass cap as  
it falls in hole

Renewal

Set 3/4" x 14" I Rod at AP4


This falls in Black Tapped Rod

New Bearing Tree

12" D. Fir N 15 E 50 F  
Scribed AP AP4 CS BT

Note:

This work also done at car

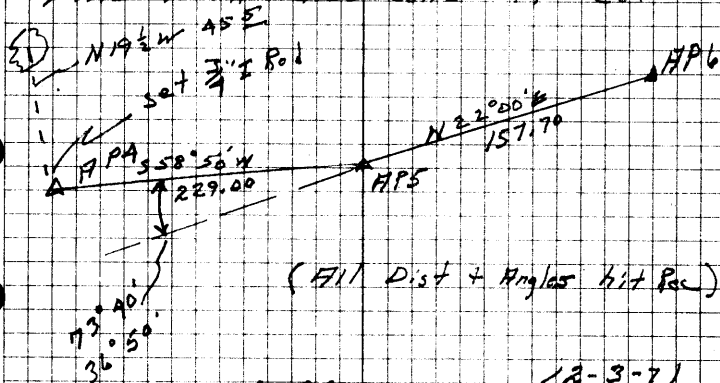

(FIT Dist + Angles hit Rec)

12-3-71

*[Signature]*

*[Handwritten notes]*

DIETZEN NO. 385-6

#189

C. S. File No. 547-63